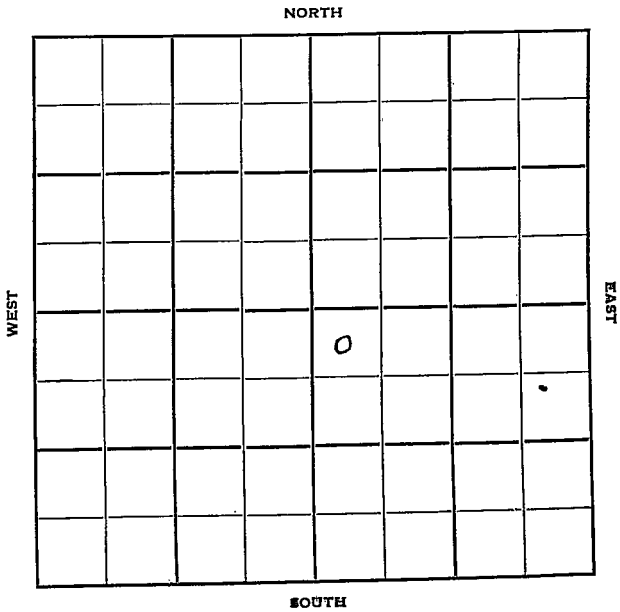


Section 3 Township 31 Range 33WWell No. #1 Hopkins Est.Company Magnolia

Seward

KANSAS

Sec. 3 Twp. 31 R. 33W ✓

Well No. #1 Hopkins Est. Farm

Magnolia Company

Barnett Drlg. Contractor

Hugoton Pool


330' Ft. from N. Line

 Ft. from S. Line

 Ft. from E. Line


330' Ft. from W. Line

NW NW SE

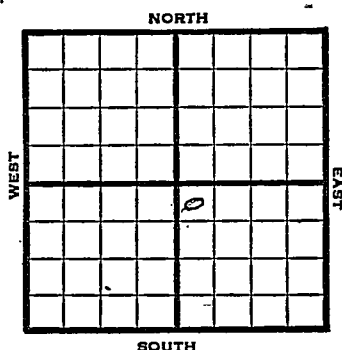

1950	Elev 2907	REPORT
9/27	Spud 9-23-50 10" @ 705'	
	WOC	
11/1	10" @ 795 6" @ 2675 TD 2810 Towanda 2751	
7	72/2701-16, 120-2754-76, 96/2628-46 48/2599-2608 28000 A Comp 18,950,000 gas TD 2810 Completed COMPLETED	

J. E. TYRA

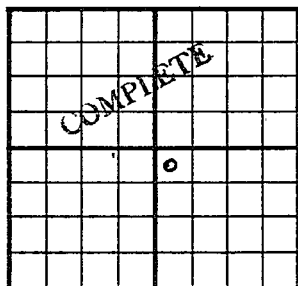County Seward State KansasSec. 3 (Blk. Twp.) 31 (Sur. Rge.) 33W Map No.Operator MagnoliaWell No. 1 Farm Hopkins Est.Elev. 2907 Location NW NW SE330 Ft. From N Line SE330 Ft. From W Line Quarter

1st. Report

Completion NOV 1 1950Remarks Hugoton PoolBarnett Drlg. - Contr.Spudding Date 9-23-50Drlg. Data Gas well TD 281010" @ 705 6" @ 2675 TD 2810Towanda 2751 72/ 2701-16 120/ 2654-7696/ 2628-46 '48/ 2599-2608 28000 AComp. 18,950,000 gas

J. E. TYRA