


Section 3 Township 31 Range 21 W
Well No. #1 Yoeman
Company Rupp-Ferguson

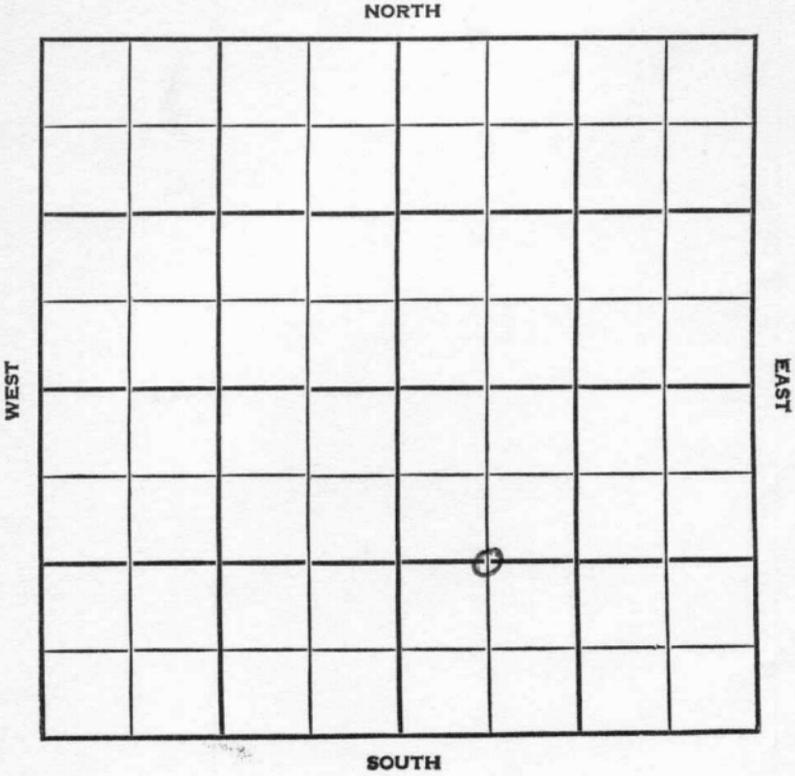

SEC. 3	TWP. 31	R. #### 21W
-----------	------------	----------------


WELL NO. #1 Yoeman FARM

COMPANY Rupp-Ferguson

CONTRACTOR Co. Tools

Calvary Creek

_____ Ft. from N. Line
 _____ Ft. from S. Line
 _____ Ft. from E. Line
 _____ Ft. from W. Line

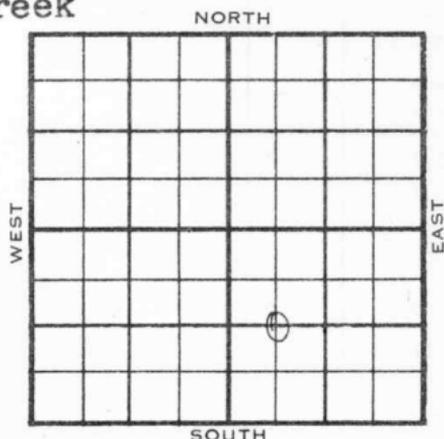

C W 1/2 SE

	ELEVATION	REPORT
1956	2234'	
2-8	Location	
5-9	Comm. 2-13-56	
	13" @ 390/400	
	DST 5166-5201 op 1 hr. gas in 3 min.	
	1,500 mcfg in 4 min., rec. 75' gcm,	
	1790/20".	
	DST 5227-37 op 1 hr., 2780' gas, rec.	
	78' o&gcm, 189' ogcmw, 120' wtr.,	
	1075#.	
	5 1/2" @ 5231/100	
	CO 20/ 5192-97, 2 bbls. acid, 1000 A,	
	24 mcfg	
	Comp. open flow 24 mcfgpd.	
	H. 4282 4282	
	Tr. 4298	
	Dg. 4390	
	BL. 4461 4460	
	L. 4487 4487	
	BKC 4936 4936	
	Marm 4953 4953	
	Ce. 5079 5078	
	M. 5178 5177	
	TD 5237'	

COMPLETED


COMPLETED

County Clark Elev. 2234
 Sec. 3 Twp. 31 Rge. 21W
 Company Rupp-Ferguson
 Farm Name Yoeman No. 1

TOPS	DEPTH	LOG	DATUM
Anh.			
Tr.			
H.	4282	4282	
Tr.		4298	
Dg.		4390	
Bl.	4461	4460	
L.	4487	4487	2259
K.C.			
B.K.C.	4936	4936	2702
ce <u>Marm</u>	4953	4953	2719
ce	5079	5078	2844
M.	5178	5177	2943
M.			
K.			
Mz.			
Mq.			
V.			
S.			
S.			
A.			
R.			
Pe.			
G.			
T.D.	5237		

Loc. in Sec. C W $\frac{1}{2}$ SE
 Geol. _____
 Contr. _____
 Co. tools _____

Pool Calvary Creek

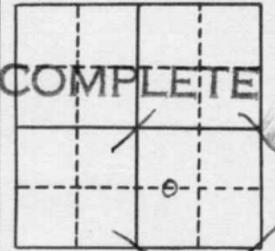

Date Comm. 2-13-56 MAY 9 1956

13" @ 390/400 DST 5166-5201 open 1 hr
 gas in 3 min. 1,500 mcfg in 4 min.
 rec. 75' gcm 1790/20" DST 5227-37
 open 1 hr. 2780' gas rec. 78' o & gcm
 189' ogcmw 120' wtr. 1075#
 5 1/2" @ 5231/100 CO 20/ 5192-97
 2 barrels acid 1000 A 24 mcfg
 Comp. open flow 24 mcfgpd

County Clark Elev. _____
 Sec. 3 Twp. 31 Rge. 21W
 Company Rupp-Ferguson
 Farm Name Yoeman No. 1

TOPS	DEPTH	LOG	DATUM
Anh.			
Tr.			
H.			
Tr.			
Dg.			
B.L.			
L.			
K.C.			
B.K.C.			
Ce.			
C.			
M.			
M.			
K.			
Mz.			
Mo.			
V.			
S.			
S.			
A.			
R.			
Pe.			
G.			
T.D.			

Loc. in Sec. C W 1/2 SE

Geol. _____

Contr. _____

Co. tools

Pool _____

Calvary Creek

FIRST REPORT			
FEB 8 '56			

Date Comm. _____
 Location _____

[Handwritten signature]

Co.
Lse.
No.
Sec.
T.
R.