

DX 78-1

Harper

KANSAS

3

31

9W

Section _____ Township _____ Range _____


Well No. #1 Brummer

Company Magnolia

NORTH

WEST

EAST

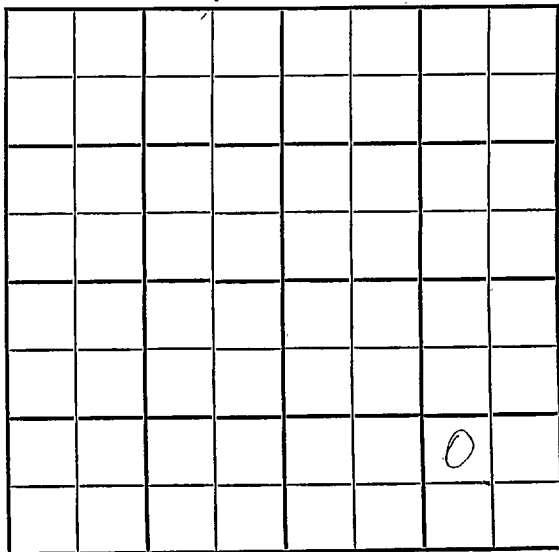

SOUTH

Date Comm.

Location

001 12 12

312

88

88

County Harper Elev. 1693
 Sec. 3 Twp. 31 Rge. 9W
 Company Magnolia
 Farm Name Brunner No. 1

TOPS	DEPTH	LOG	DATUM	Loc. in Sec.
Ank.				NW SE SE
TP.				
H.				
Tr.				
Dg.				
BL.				
L.	3704			Geol.
K.C.				Contr.
B.K.C.				
Ce.				
C.				
M.	4435			Pool
M.				
K.				Spivey Grabs
Mz.				
Me.				
V.				
S.				
S.				
A.				
R.				
PE.				
G.				
TD.	4535			

COMPLETE
 DEC 20 '56

Date Comm.

Location NOV 24 '56 10-18-56
9578 259/250 D 2050 or 31 '56
D 4287 NOV 7 '56 DST 4437-60 1 hr.
2400' G1R rec 97' 50' 6CM
FP 50-65 BHP 285/20 DST
4460-85 1 hr. G/58" rec 30' 50'
GCM + 60' H 6' 6CM + 255' Md 400'
+ 52' SW BHP 1285/20" 5 1/2 4534
1200 CO 4509 120/4440-60 NOV 13 '56

1/4 11 Bo no lw stue +
 G56 Frae 10x10 NOV 21 '56 Flwd
 80 Bo + 80 BW 18 hrs 5/16" ch
 TP 180 CP 580# Flwd 24
 Bo + 24 BW 10 hrs 5/16" ch
 TP 160 CP 580# NOV 28 '56 DEC 5 '56
 Flwd 124 Bo + 36 BW
 24 hrs 9/32" ch TP 190
 CP 600 grav 33.5° DEC 12 '56
 DEC 19 '56 Flw 124 Bo + 36 BW
 24 hrs 9/32" ch ga 132
 MCFG. QOR 1064:1 TP 190
 CP 600 grav 33.5°