

Harper


KANSAS

SECTION 3 TOWNSHIP 31 RANGE 9W

WELL NO. #1 Nellie McDaniel Unit

COMPANY Magnolia

NORTH SE NW NW

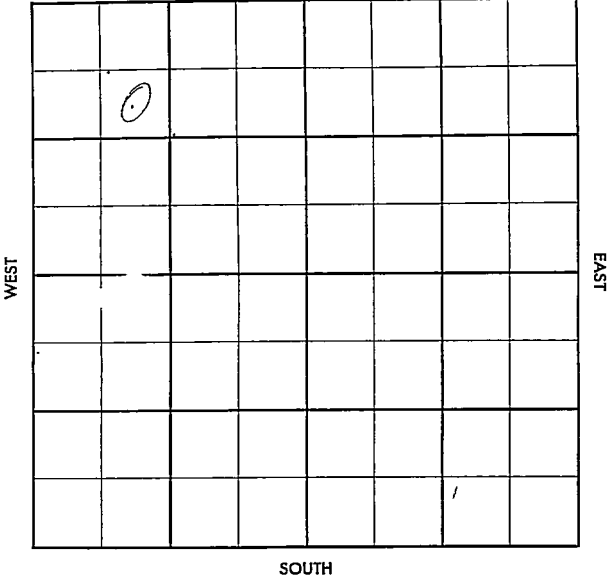

County Harper

Elev. _____

Sec. 31 Twp. 31

Rgs. 9W

Company Magnolia

FarmName Neillie McDaniel Unit

No. 1

TOPS

DEPTH

LOG

DATUM

Loc. in Sec. _____

Anh. _____

SE NW NW

Tp. _____

H. _____

Tr. _____

Dg. _____

Bl. _____

L. _____

Geol. _____

K.C. _____

Contr. _____

B.K.C. _____

Ce. _____

G & M Tools

C. _____

M. _____

Pool _____

M. _____

K. _____

Mz. _____

Mq. _____

V. _____

S. _____

S. _____

A. _____

R. _____

PE. _____

G. _____

T.D. _____

WAR 27 '57

FIRST REPORT

Date Comm. _____

Location _____

~~27~~

Co.

Use.

Notes

Sec.

T.

R.

County Harper

Elev. 1711

Sec. 3

Twp. 31

Rge. 9W

Company Magnolia

Farm Name Nellie McDaniel Unit

No. 1

TOPS	DEPTH	LOG	DATUM
Anh.			
Tr.			
H.			
Tr.			
Dg.			
Bl.			
L.			
K.C.	<u>3718</u>	<u>3723</u>	
B.K.C.			
Ce.			
C.			
M.	<u>4427</u>	<u>4429</u>	
M.			
K.			
Mz.			
Me.			
V.			
S.			
S.			
A.			
R.			
PE.			
G.			
T.D.	<u>4525</u>		

Loc. in Sec. SE NW NW

Geol. _____

Contr. _____

G & M Tools

Pool _____

	APR 17 '57	
ABANDONED		

Date Comm. _____

Location APR 3 '57 3-29-57 958

239/258 (1) 2080 APR 10 '57

DST 4430-71 APR 17 '57 gas 1 hr

G/50" ga 196 MCF/10" rec

70' S GCM BHP 1470/20

D E A

Co.

Log.

No.

Sec.

T.

R.