


Section 30 Township 31 Range 13W

Well No. #1 Mills

Company Barbara Oil

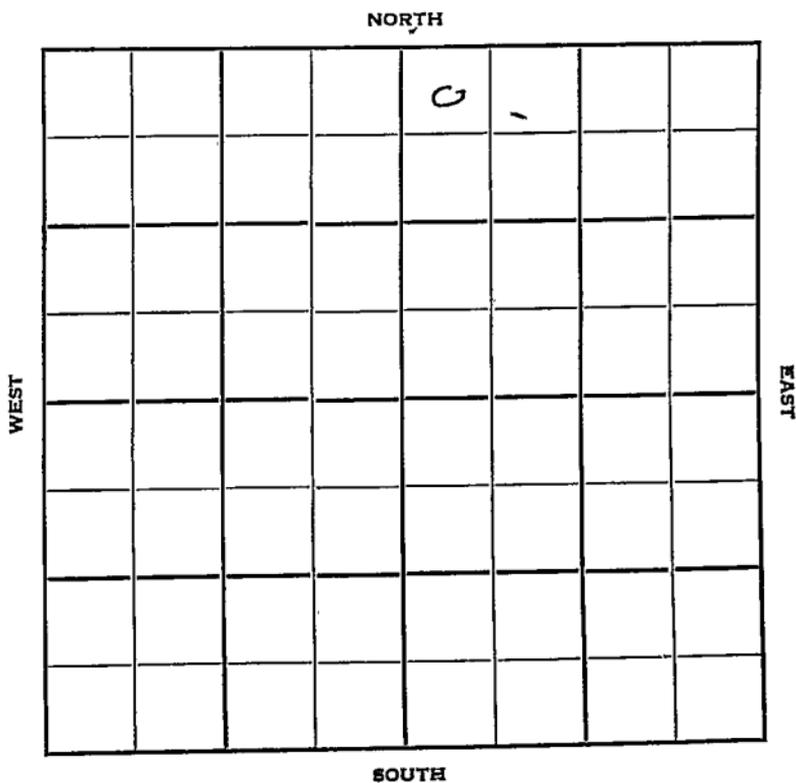

30

31

13 W

Sec. _____ Twp. _____ R. _____

1 Mills

Well No. _____ Farm _____

Barbara Oil

Company _____

Contractor _____


Wildcat

330 Ft. from N. Line

_____ Ft. from S. Line

_____ Ft. from E. Line

330 Ft. from W. Line

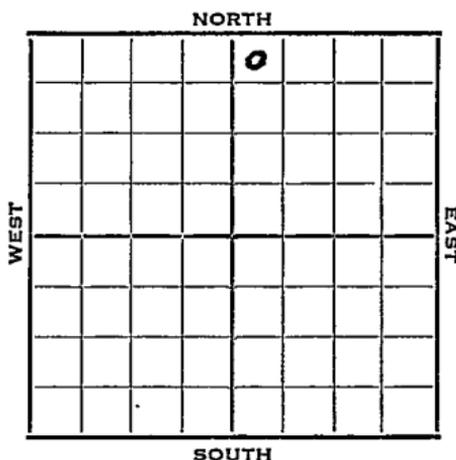

NW NW NE

C.S.O. - \$5000 DHM

1952 Elev. 1591' REPORT

4/16 RUR

4/23 "

4/30 12" @ 193' WOC

5/7 Drlg. 2915'

5/14 Heeb. 3579' Dodge 3597

Lans. 3752

Drlg. 4115'

5/21 Spud 4-27-52 D&A TD 4665'

12" @ 193' Heeb. 3579 Dodge 3597

Lans. 3752' Miss. 4250

DST 4329-45 open 20 min. rec. 20' mud

Kh. 4366 Viola 4433

DST 4465-80 open 35 min. rec. 30' mud

Simp. 4541 Arb. 4634

TD 4665' D&A

ABANDONED

