

KANSAS

Form 51—5M—7-39—Palace

Barber

Section ~~31~~ 30 Township 31 Range 11-W


Well No. #2 Nuckolls

Company Lario Oil & Gas

NORTH

Whelan Pool

WEST

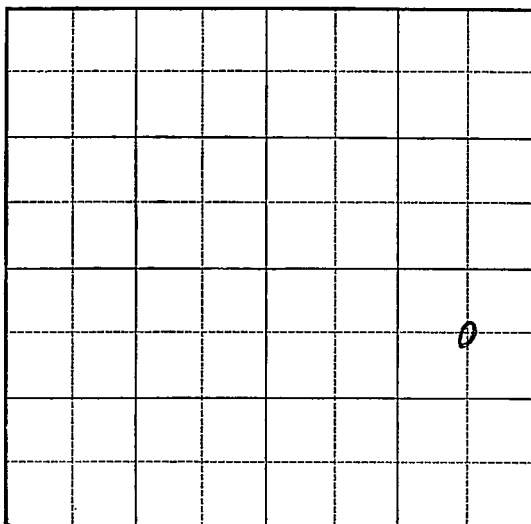

EAST

SOUTH

Map No. 61 Sec. 31 Twp. 31 R. 11WWell No. 2 NuckollsLario Oil & Gas

Company

Contractor

FIRST REPORT

SECTION PLAT

660 C NE SE
Ft. from N. Line Ft. from S. Line660 Ft. from E. Line Ft. from W. Line

			o

WHELAN POOL

Location XRig up

Drilling and Remarks:

RECORD

Cased in., ft.Sand Gas Oil Total Depth

PRODUCTION

1st 24 hrs. Nat. 1st 24 hrs. after shot Gas Cu. Ft.Dry Hole Abandoned

Date

MAY 22 1940S. J. LEWIS

Scout

Map No. 61 Sec. 30 Twp. 31 R. 11WWell No. 2 NuckollsLario Oil & Gas

Company

CORRECTION


Contractor

C NE SE

660 Ft. from N. Line Ft. from S. Line660 Ft. from E. Line Ft. from W. Line

WHELAN POOL

SECTION PLAT

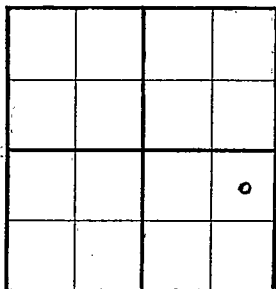Location Rig up

Drilling and Remarks:

Reported

31-31-11W

RECORD

Cased in., ft.Sand Gas Oil Total Depth

PRODUCTION

1st 24 hrs. Nat. 1st 24 hrs. after shot Gas Cu. Ft.Dry Hole Abandoned

Date

JUN 10 1940 19 S. J. LEWIS Scout

Map No. 61 Sec. 30 Twp. 31 R. 11WWell No. 2 NuckollsLario Oil & Gas CompanyCOMPLETED Contractor**SECTION PLAT**

C NE SE

			o

660 Ft. from N. Line Ft. from S. Line660 Ft. from E. Line Ft. from W. Line

WHELAN POOL

Location Rig up

Drilling and Remarks:

*Well 4301**5" C 4301**Depthograph R & X*
*3939**Map 3000***RECORD**Cased in., ft.Sand Gas Oil Total Depth 4314**PRODUCTION**1st 24 hrs. Nat. 1st 24 hrs. after shot Gas Cu. Ft.Dry Hole Abandoned

Date

JUL 17 1940 19 S. J. LEWIS Scout