

DX 78-1


Barber

KANSAS

Section 30 Township 31 Range 12W

Well No. #1 Clarke

Company Arora Gasoline

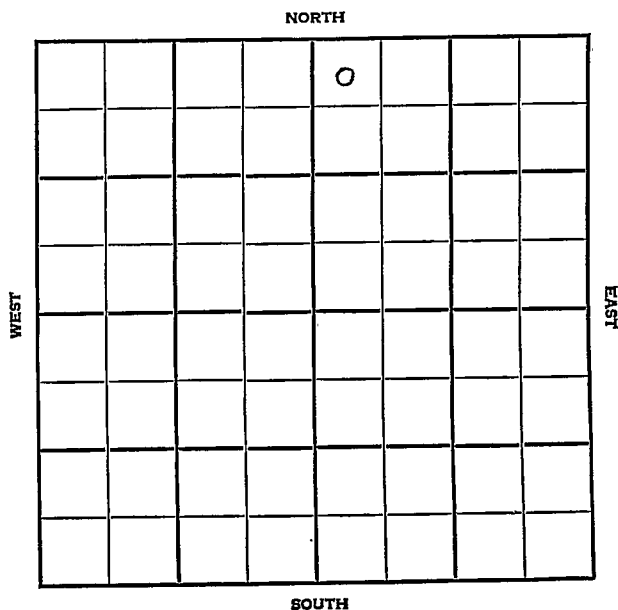

Barber

KANSAS

SEC.	TWP.	R.
30	31	12W

WELL NO. **1 Clarke** FARM

COMPANY **Aurora Gasoline**


CONTRACTOR **Berwick
Wildcat**

330' _____ Ft. from N. Line

_____ Ft. from S. Line

_____ Ft. from E. Line

330' _____ Ft. from W. Line

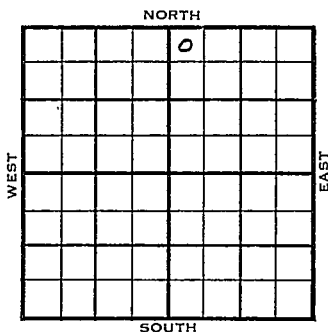

NW NW NE
Superior DHM
Arb Test

1955	ELEVATION 1615	REPORT
------	-------------------	--------

6/1 Location

6/29 Comm 6-7-55

Anh 1373

H 3534 3529

Tr 3562

Dg 3607 3579

Doug 3602

L 3735 3728

M 4236 4226

K 4341

Chat 4414

V 4449 4442

S 4542 4534

A 4655 4644

TD 4680 4672

8 5/8" @ 210/150 DST 3604-30 open

1 hr Rec 190' muddy sw 1190# D&A

ABANDONED

County Barber Elev. 1615
 Sec. 30 Twp. 31 Rge. 12W
 Company Aurora Gasoline
 Farm Name Clarke No. 1

Co.

TOPS	DEPTH	LOG	DATUM
Anh.	1373		
Tp.			
H.	3534	3529	1914
Tr.		3562	1947
Dg.	3607	3579	1964
BT. <u>Doug</u>		3603	1987
L.	3735	3728	2113
K.C.			
B.K.C.			
Ce.			
C.			
M.	4236	4226	2611
M.			
K.		4341	2726
Mr. <u>Chat</u>		4414	2799
Me.			
V.	4449	4442	2827
S.			
S.	4542	4534	2919
A	4655	4644	3029
R.			
Pe.			
G.			
TR.	4680	4672	

Loc. in Sec. NW NW NE

Geol. _____

Contr. _____

Berwick

Pool _____

Wildcat

		0	

ABANDONED

Lse.

No.

Date Comm. 6-7-55 JUN 29 1955

8 5/8" @ 210/150 DST 3604-30 open 1 hr

Rec. 190' muddy sw 1190#

D & A

T.

R.

Sec.