

# KANSAS


Form 51-5M-7-39-Palace

Barber

Section 30 Township 31 Range 11-W

Well No. #1 Nuckolls

Company Olson Oil Whelan Pool

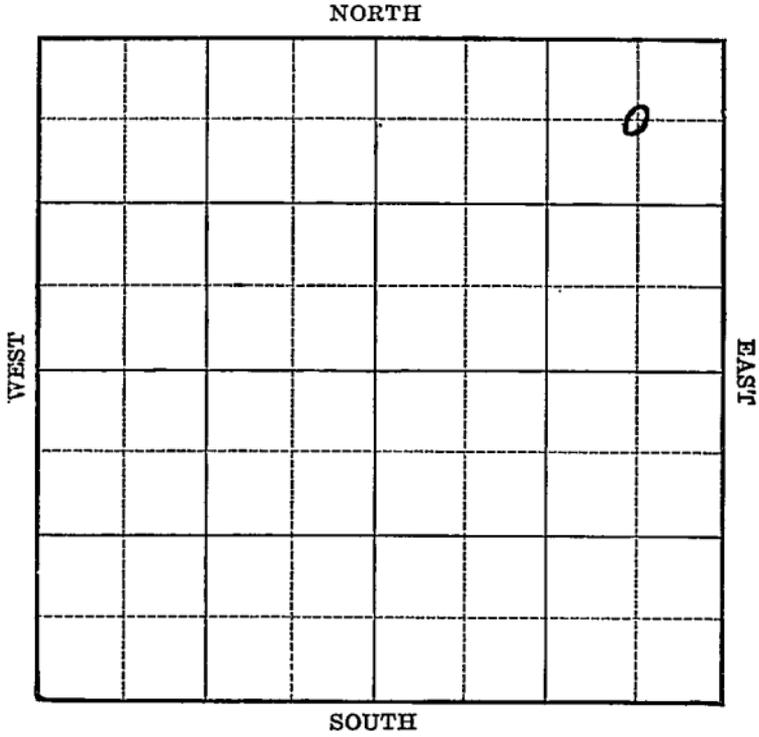



1940  
8/14

Miss. 4293 $\frac{1}{2}$ '

5" - 4299'

T.D. 4337'

Potential 943 bbls., flow.

COMPLETED

Barber

Map No. 61 Sec. 30 Twp. 31 R. 11WWell No. 1 NuckollsOlson Oil

Company

Contractor

## FIRST REPORT

C NE NE

660 Ft. from N. Line

\_\_\_\_ Ft. from S. Line

660 Ft. from E. Line

\_\_\_\_ Ft. from W. Line

## SECTION PLAT

|  |  |  |   |
|--|--|--|---|
|  |  |  | o |
|  |  |  |   |
|  |  |  |   |
|  |  |  |   |

WHELAN POOL

Location X

Rig up \_\_\_\_\_

Drilling and Remarks:

## RECORD

Cased \_\_\_\_\_ in., \_\_\_\_\_ ft.

Sand \_\_\_\_\_

Gas \_\_\_\_\_

Oil \_\_\_\_\_

Total Depth \_\_\_\_\_

## PRODUCTION

1st 24 hrs. Nat. \_\_\_\_\_

1st 24 hrs. after shot \_\_\_\_\_

Gas \_\_\_\_\_ Cu. Ft.

Dry Hole \_\_\_\_\_

Abandoned \_\_\_\_\_

Date

MAY 8 1940<sub>19</sub>S. J. LEWIS Scout

|                  |            |
|------------------|------------|
| Misc. Small Maps | <i>DMJ</i> |
| Cards            | <i>DMJ</i> |
| Tracing          | <i>DMJ</i> |
| France Map       | <i>DMJ</i> |
| Scarborough Map  | <i>DMJ</i> |
| Moody Map        | <i>DMJ</i> |
| Geological Dept. |            |
| Moody Plat Book  |            |

Map No. 61 Sec. 30 Twp. 31 R. 11W

Well No. 1 Nuckolls "B"

Olson Oil Company

Contractor

**COMPLETED**

**SECTION PLAT**

C NE NE

660 Ft. from N. Line

\_\_\_\_\_ Ft. from S. Line

660 Ft. from E. Line

\_\_\_\_\_ Ft. from W. Line

|  |  |  |   |
|--|--|--|---|
|  |  |  | 0 |
|  |  |  |   |
|  |  |  |   |
|  |  |  |   |

WHELAN POOL

Location \_\_\_\_\_

Rig up \_\_\_\_\_

Drilling and Remarks:

*Miss 4293 1/2*  
*5" @ 4299*  
*Flow 943 P.S.*

**RECORD**

Cased \_\_\_\_\_ in., \_\_\_\_\_ ft.

Sand \_\_\_\_\_

Gas \_\_\_\_\_

Oil \_\_\_\_\_

Total Depth 4387

**PRODUCTION**

1st 24 hrs. Nat. \_\_\_\_\_

1st 24 hrs. after shot \_\_\_\_\_

Gas \_\_\_\_\_ Cu. Ft.

Dry Hole \_\_\_\_\_


Abandoned \_\_\_\_\_

Date

AUG 14 1940 19

S. J. LEWIS Scout

50 51 52  
53 54 55

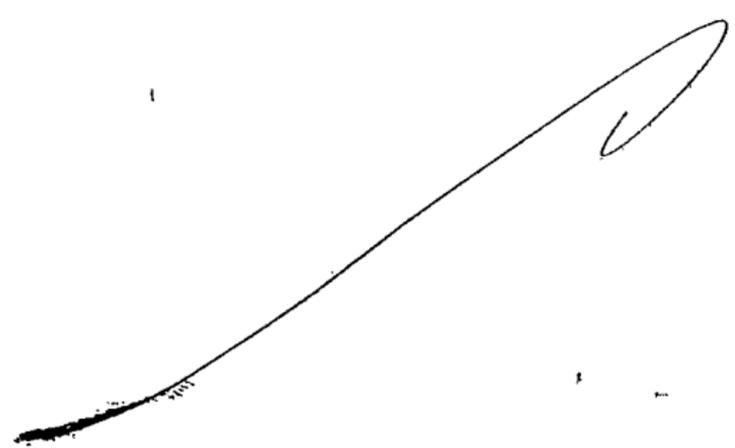

|                  |             |
|------------------|-------------|
| Misc Small Maps  | <i>Paul</i> |
| Cards            | <i>Paul</i> |
| Tracing          | <i>Job</i>  |
| France Map       | <i>Job</i>  |
| Scarborough Map  | <i>Job</i>  |
| Moody Map        |             |
| Geological Dept. |             |
| Moody Flat Book  |             |