

Barber


KANSAS

Form 51-5M-7-39-Palace

Section 30 Township 31 Range 11-W

Well No. #2 Nuckolls

Company Jim Davis

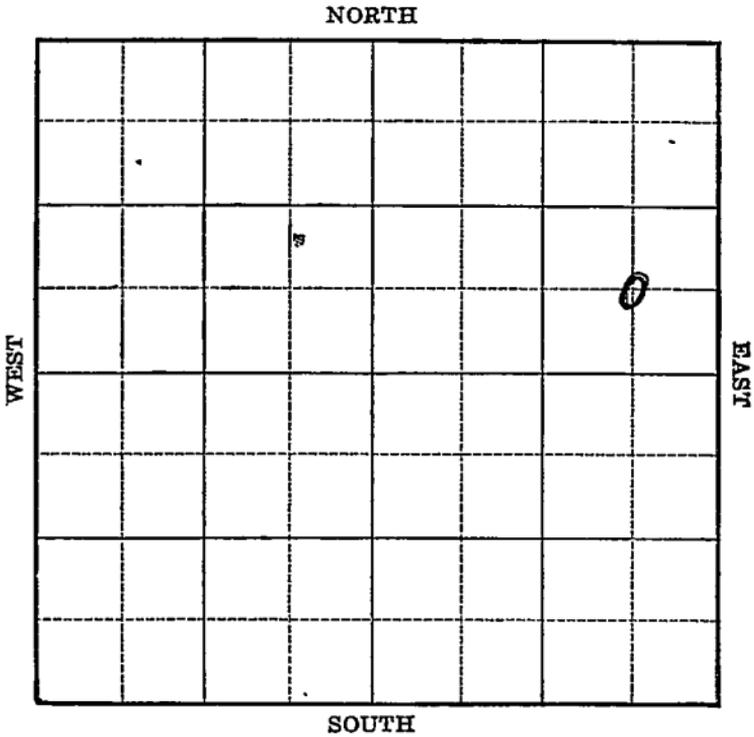

1940
6/26

Miss. 4321'

5" - 4322'

T.D. 4377'

Shot 80 qts. 4330-60'

Potential 785 bbls., pump.

COMPLETED

Map No. 61 Sec. 30 Twp. 31 R. 11WWell No. 2 NuckollsJim Davis Company

Contractor

FIRST REPORT**C SE NE**

_____ Ft. from N. Line

660 Ft. from S. Line660 Ft. from E. Line

_____ Ft. from W. Line

SECTION PLAT

WHELAN POOL

Location _____

Rig up _____

Drilling and Remarks:

Cellar**RECORD**

Cased _____ in., _____ ft.

Sand _____

Gas _____

Oil _____

Total Depth _____

PRODUCTION

1st 24 hrs. Nat. _____

1st 24 hrs. after shot _____

Gas _____ Cu. Ft.

Dry Hole _____

Abandoned _____

Date

APR 3 1940

19

S. J. LEWIS

Scout

Misc. Small Maps.....
Cards.....
Tracing.....
France Map.....
Scarborough Map.....
Moody Map.....
Geological Dept.
Moody Plat Book.....

Handwritten initials/signature

Map No. 61 Sec. 30 Twp. 31 R. 11W

Well No. 2 Nucholls

Jim Davis Company

Contractor

COMPLETED

SECTION PLAT

C SE NE

			0

 Ft. from N. Line

660 Ft. from S. Line

660 Ft. from E. Line

 Ft. from W. Line

WHELAN POOL

Location

Rig up

Drilling and Remarks:

Miss 4321
5" @ 4322
80 gts. 4330-60
Pump 785 P.S.

RECORD

Cased in., ft.
 Sand
 Gas
 Oil
 Total Depth 4377

PRODUCTION

1st 24 hrs. Nat.
 1st 24 hrs. after shot
 Gas Cu. Ft.
 Dry Hole
 Abandoned

Date

JUN 26 1940 19

S. J. LEWIS Scout

Misc Small Maps *DMY*
Cards *DMY*
Tracing *DMY*
France Map *DMY*
Scarborough Map *DMY*
Moody Map
Geological Dept.
Moody Flat Book