


Company SolorOil

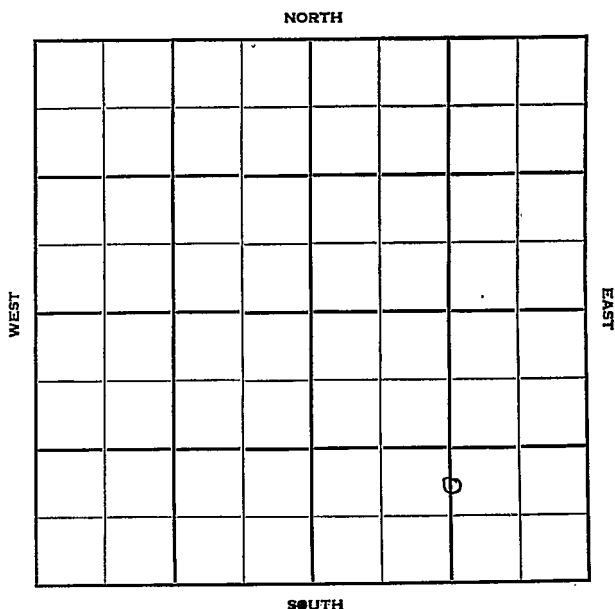

Barber

KANSAS

Sec. 30 Twp. 31 R. 11W

Well No. #3 Nuckolls Farm

Solor Oil Company

Rine Contractor

Wheland


 Ft. from N. Line

990 Ft. from S. Line

1320 Ft. from E. Line

 Ft. from W. Line

C N/2 S/2 SE

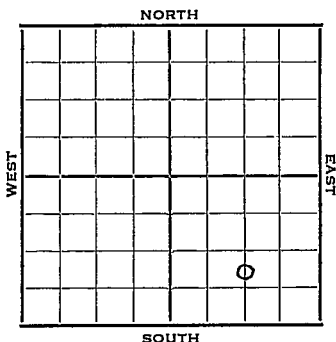

1952 Elev. 1553' REPORT

1/16 Spud 1-13-52
8" @ 155' WOC

2/6 TD 4332 5" @ 4310
CO to 4332 POP

2/13 POP

2/20 Spud 1-13-52
Oil Well TD 4332'
8" @ 155' Elgin sd 3396 Oread 3550
Br. Li 3718 B KC 4082 Miss. 4307
DST 4309-32 Spray oil 20 min.
5" @ 4310 CO 4332
Comp. 50 bopd 10% wtr.


COMPLETED

County Barber State Kansas
 Sec. 30 (Blk. Twp.) 31 (Sur. Rge.) 11W Map No.

Operator Solor Oil

Well No. 3 Farm Nuckolls

Elev. Location C N/2 S/2 SE

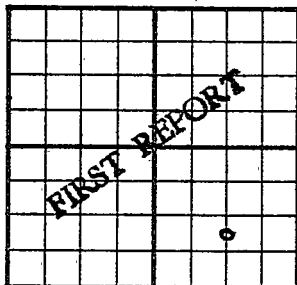

990 Ft. From S Line SE

1320 Ft. From E Line Quarter

Ist. Report JAN 16 1952

Completion

Remarks

Rine - Contr.


Spudding Date 1-13-52

Drlg. Data Wheland

8" @ 155' W.O.C.

J. E. TYRA

County Barber State Kansas
 Sec. 30 (Blk. 31 (Sur. 11W Map No.
 Twsp. Rge.)
 Operator Solar Oil
 Well No. 3 Farm Nuckolls
 Elev. 1553 Location C N L. S $\frac{1}{2}$ SE

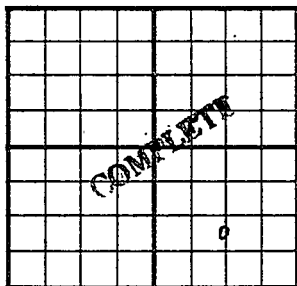

990 Ft. From S Line SE
1320 Ft. From E Line Quarter
 Ist. Report
 Completion FEB 20 1952
 Remarks Wheland Pool
Rine Drlg. - Contr.
 Spudding Date 1-13-52

Drlg. Data Oil well TD 4332
8" @ 155 Elgin sand 3396 Oread 3550
Br. lime 3718 B KC 4082 Miss. 4307
DST 4309-32 Spray oil 20 min.
5" @ 4310 CO 4332 Comp. 50 bopd 10% w