


Section 30 Township 31 Range 11W

Well No. #3 Nuckolls

Company Lario Oil & Gas

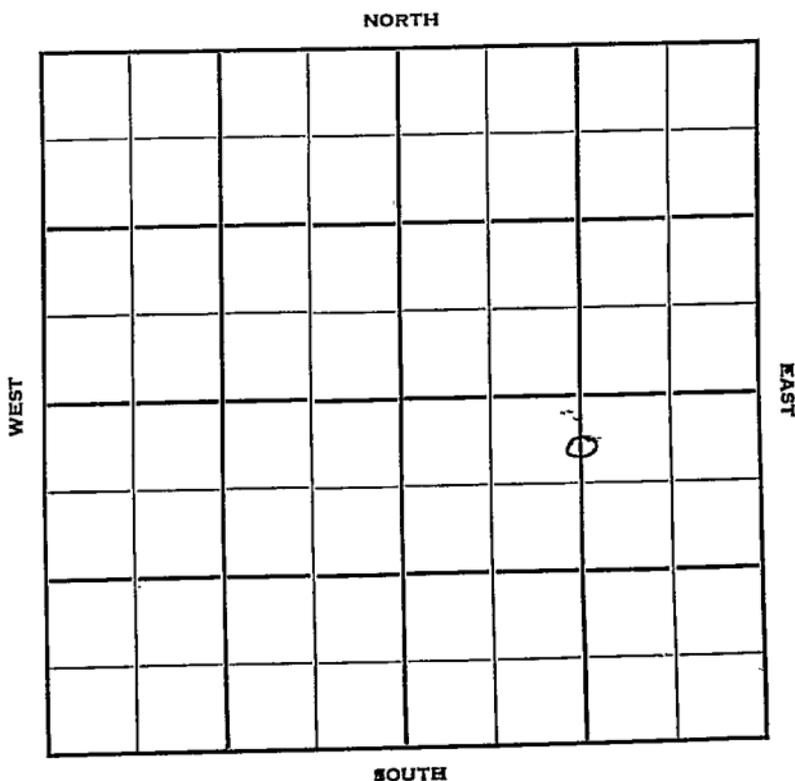

Sec. 30 Twp. 31 R. 11W

Well No. #3 Nuckolls Farm

Lario Oil & Gas Company

Patton - Contr. Contractor


330' Ft. from N. Line

Ft. from S. Line

1320' Ft. from E. Line

Ft. from W. Line

G N/2 N/2 SE

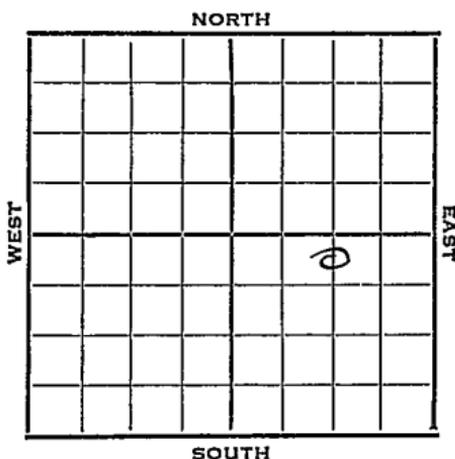

1952 Elev. 1552' REPORT

5/7 Spud 5-4-52
@ 130
Drlg. 250'

5/14 Elgin sd 2383
DST 3356-3412', e/4 hr. gas 10"
gauge 1,200,000 gas 200' gcm
650' SW 890# Drlg. 3685'

5/21 Miss 4306
DST 4300-4315, 1 hr. 45' GCM
960# DST* 4300-25' RTD, 1 hr.
x 800' OCM 1125# 5" @

5/28 5" @ 4306

6/11 Spud 5-4-52
Oil Well TD 4325' 8" @ 310
Elgin sd 2383
DST 3356-3412 open 3/4 hr. gas
in 10 min. 1,200,000 g 240' gcm
650' sw Miss. 4306
DST 4300-25 open 1 hr. rec. 800' ocm
5" @ 4306' CO to 4325 S/3 to 4 bfph
Comp. 55 bopd 5 bw

COMPLETED


County **Barber** State **Kansas**

Sec. **30** (Blk. Twp.) **31** (Sur. Rge.) **11W** Map No.

Operator **Lario Oil & Gas**

Well No. **3** Farm **Nuckolls**

Elev. Location **C N/2 N/2 SE**

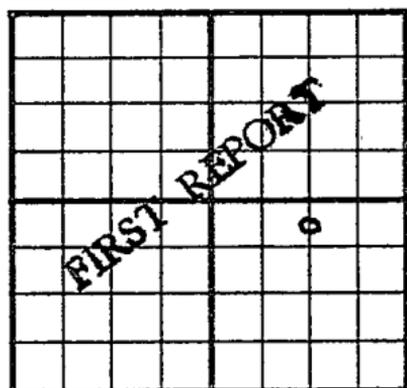

330 Ft. From **N** Line **SE**

1320 Ft. From **E** Line Quarter

1st. Report **MAY 7 1952**

Completion

Remarks


Patton - Contr.

Spudding Date **5-4-52**

Drlg. Data

@ 130 Drlg. 250

J. G. McGEHEE

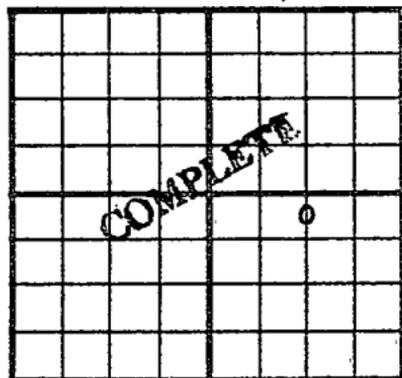County Barber State KansasSec. 30 (Blk. Twp.) 31 (Sur. Rge.) 11W Map No.Operator Larion Oil & GasWell No. 3 Farm NuckollsElev. 1552 Location C N L N $\frac{1}{2}$ SE330 Ft. From N Line SE1320 Ft. From E Line Quarter

1st. Report

Completion JUN 11 1952

Remarks

Patton - Contr.Spudding Date 5-4-52Drlg. Data Oil well TD 43258" @ 310 Elgin sand 2383 DST 3356-3412open 3/4 hr. gas in 10 min. 1,200,000 g240' gcm 650' sw Miss. 4306DST 4300-4315 open 1 hr. Rec. 45' gcmDST 4300-25 open 1 hr. Rec. 800' ocm5" @ 4306 CO to 4325 S/ 3 to 4 bfpComp. 55 bopd 5 bw

J. G. McGEHEE