

KANSAS

FORM 51 5M 4-41 PETROL


Barber

Section 30 Township 31 Range 11-W

Well No. #3 Nuckols "A" (Nuckolls)

Company Olson Oil

NORTH Whelan pool

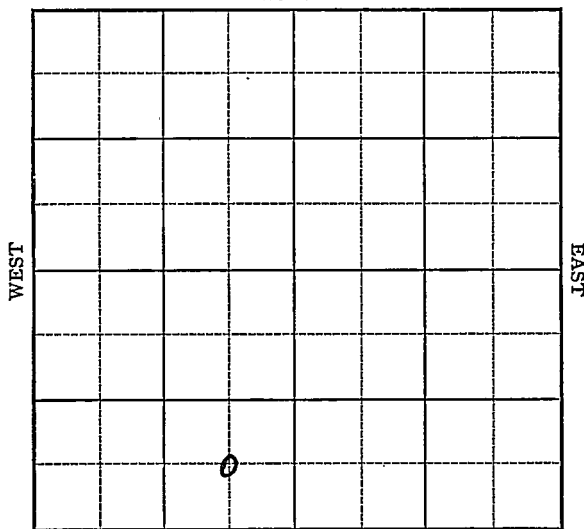

SOUTH

Map No. 61 Sec. 30 Twp. 31 R. 11WWell No. 3 Nuckols "A"Olson Oil CompanyFIRST REPORT Contractor

C SE SW

 Ft. from N. Line660 Ft. from S. Line660 Ft. from E. Line Ft. from W. Line

WHELAN POOL

SECTION PLAT

	0		

Location Rig up

Drilling and Remarks:

Cellar

RECORD

Cased in., ft.Sand Gas Oil Total Depth

PRODUCTION

1st 24 hrs. Nat. 1st 24 hrs. after shot Gas Cu. Ft.Dry Hole Abandoned

Date

MAY 27 1941

19

S. J. LEWIS Scout

Map No. 61 Sec. 30 Twp. 31 R. 11WWell No. 3 Nuckols "A"Olson Oil

Company

COMPLETED

Contractor

C SE SW

 Ft. from N. Line660 Ft. from S. Line660 Ft. from E. Line Ft. from W. Line

SECTION PLAT

		.	
			.
	o		

WHELAN POOL

Location Rig up

Drilling and Remarks:

Miss 4255
5" @ 4257
40 g to 4265-75.
Flow 394 RY

316 g

RECORD

Cased in., ft.Sand Gas Oil Total Depth 4290

PRODUCTION

1st 24 hrs. Nat. 1st 24 hrs. after shot Gas Cu. Ft.Dry Hole Abandoned

Date

JUL 16 1941 19S. J. LEWIS

Scout