


Section 30 Township 31 Range 11-W

Well Number #1 Swartz

Company Vaccers Corp.

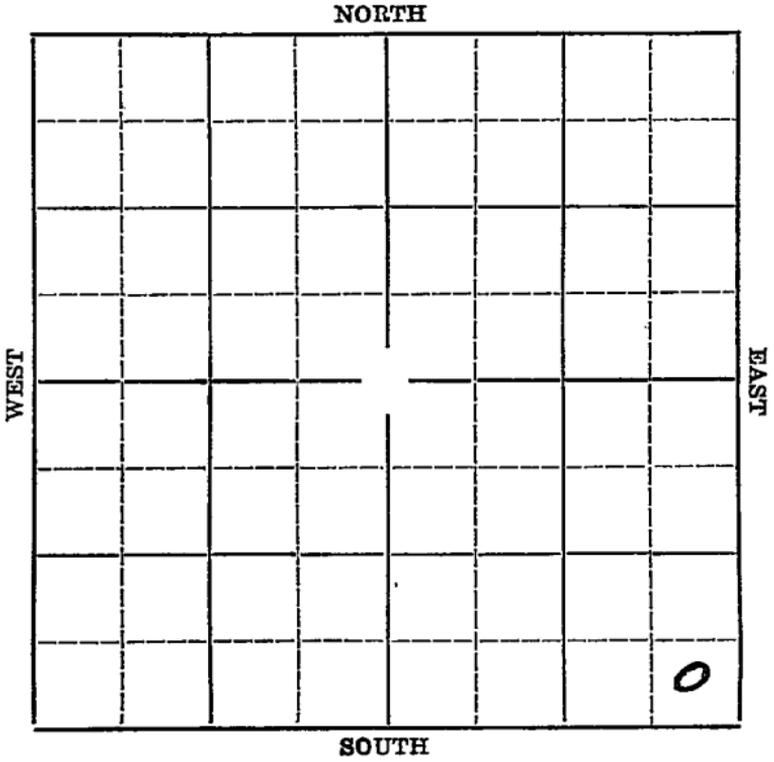

Map No. **KANSAS** Sec. **30** Twp. **31** R. **11W**

Well No. **#1 Swartz** Farm

Vaccers Corp. Company


_____ Ft. from N. Line

330' Ft. from S. Line

330' Ft. from E. Line

_____ Ft. from W. Line

Elev. 1557

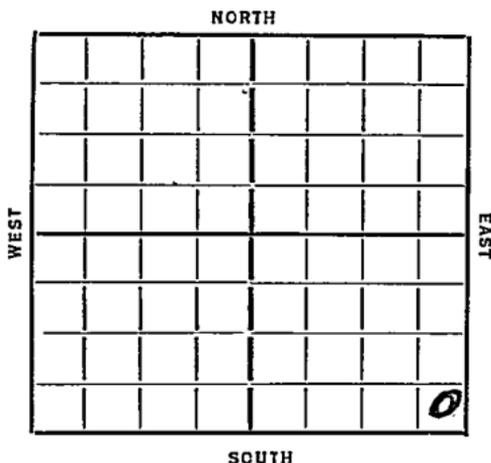

~~1936~~ REPORT

7/8 Rotary Rig.

7/16 ~~0-~~

7/23 Rigging up.

7/30 12" @ 116'. Drlg. 1583'.

8/6 Drlg. 2956'.

8/13 Drlg. 3940'.

8/20 Chat 4304'. Show oil TD 4309'.

8/25 Chat 4304 T.D. 4316

Flow 15 minutes every hour

Flowing into pits No tankage

36.6 gravity at 76 (Tel)

9/3--9/10--9/18--

9/24--

10/1 Pinched in flows 40 bbls per day.

10/8 Pump 13 1/2 bbls per hour.

10/15 No more tests.

10/22 ~~Rigging~~ Will deepen.

10/29 4315' TD 3900' of oil in hole.

4360' equals 4314'.

OVER

1936

11/4--Chat. 4303

Pot. 1164 18hrs. No water

Total Depth 4417 $\frac{1}{2}$

COMPLETED

Map No. 61 Sec. 30 Twp. 81 R. 11WWell No. 1 SwartzVaccers Corp Company

Contractor

SECTION PLAT

 Ft. from N. Line330 Ft. from S. Line330 Ft. from E. Line Ft. from W. Line

FIRST REPORT

Location Rig up

Drilling and Remarks:

Rotary Rig

RECORD

Cased in., ft.Sand Gas Oil Total Depth

PRODUCTION

1st 24 hrs. Nat. 1st 24 hrs. after shot Gas Cu. Ft.Dry Hole Abandoned

Date

JUL 8 1936 19

S. J. LEWIS

Scout

[Handwritten scribbles and lines]

Returned	<i>[Signature]</i>
Cards	<i>[Signature]</i>
Tracing	<i>[Signature]</i>
France Map	<i>[Signature]</i>
Scarborough Map	<i>[Signature]</i>
Moody Map	<i>[Signature]</i>
Scarborough Plat Book	
Moody Plat Book	

KANSAS

Map No. 61 Sec. 30 Twp. 31 R. 11W

Well No. 1 Swartz

Vaccara Corp Company

Contractor

SECTION PLAT

_____ Ft. from N. Line

330 Ft. from S. Line

330 Ft. from E. Line

_____ Ft. from W. Line

COMPLETED

Location _____

Rig up _____

Drilling and Remarks:

Chk 4303

Pos 1164

18 hrs

No water.

RECORD

Cased _____ in., _____ ft.

Sand _____

Gas _____

Oil _____

Total Depth 4417 1/2

PRODUCTION

1st 24 hrs. Nat. _____

1st 24 hrs. after shot _____

Gas _____ Cu. Ft.

Dry Hole _____

Abandoned _____

Date

NOV 4 1936

S. J. LEWIS Scout

[Faint, illegible text and a large handwritten scribble]

Returned	
Cards	<i>P.F.</i>
Tracing	<i>JWP</i>
France Map	<i>[initials]</i>
Scarborough Map	<i>[initials]</i>
Moody Map	<i>[initials]</i>
Scarborough Plat Book	
Moody Plat Book	