


FORM 51 Barber

KANSAS

Section 30 Township 31 Range 11W

Well No. 3 Swartz "A"

Company Aylward Drlg.

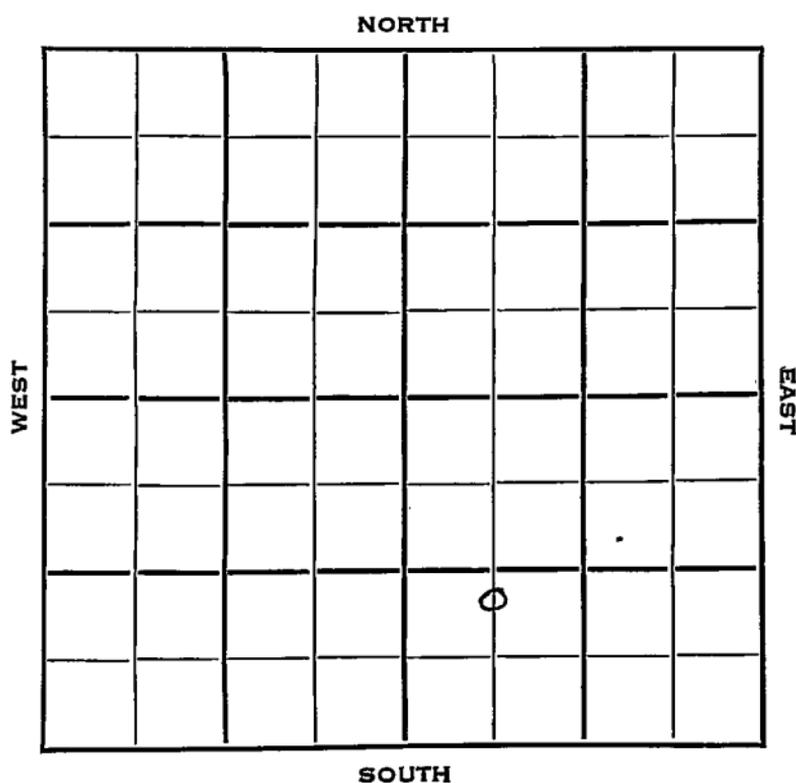

Barber

Sec. 30 Twp. 31 R. 11W

Well No. 3 Swartz "A" Farm

Aylward Drlg. Company


Contractor

Ft. from N. Line

990 Ft. from S. Line

Ft. from E. Line

660 Ft. from W. Line

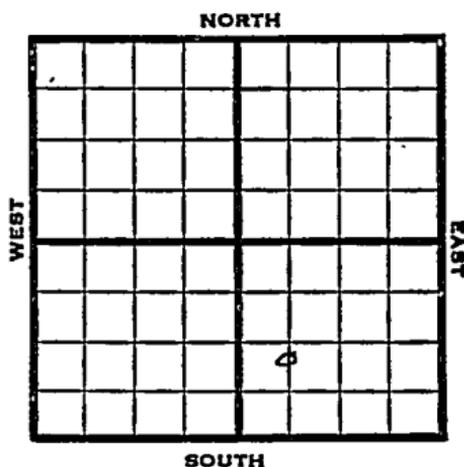

C N L SW SE

1953

Elev. 1518 REPORT

1/7 Spudding Date 1/2/53
8" @ 122 Drlg. 1630

1/22 Doug 3494, Miss 4266
RTD 4275
5" @ 4268

1/29 DD 4297' TD 1 1/2 BFPH S/15 BO 12 hrs.
F/22 BO 12 hrs.

2/5 F 25BOPD

2/11 Spudding 1/2/53
Oil well TD 4297
8" @ 122 DST 3341-60 open 1/2 hr.
Rec. 670,000 gas 65' gcm 700#
Doug. 3494 DST 3474-3560 open 1/2 hr
Rec. 1 1/4 mcfg 180' gcm 1425#
Miss. 4266 TD 4275 5" @ 4268 DD 4297
1 1/2 bfph S/15 bo 12 hr. F/ 22 bo
12 hr. Comp. 25 bopd

COMPLETED

County Barber State Kansas

Sec. 30 (Blk. 31 (Sur. 11W (Twp. 31 (Rge. 11W Map No.

Operator Aylward Drig.

Well No. 3 Farm Swartz "A"

Elev. _____ Location C N L SW SE

990 Ft. From S Line SE

660 Ft. From W. Line Quarter

Ist. Report JAN 7 1953

Completion _____

Remarks _____

Spudding Date 1-2-53

Drig. Data _____

8" @ 122' drig. 1630

