


Section 30 Township 31 Range 11W

Well No. 47 Schartz "A" (Swartz)

Company Aylward Drlg.

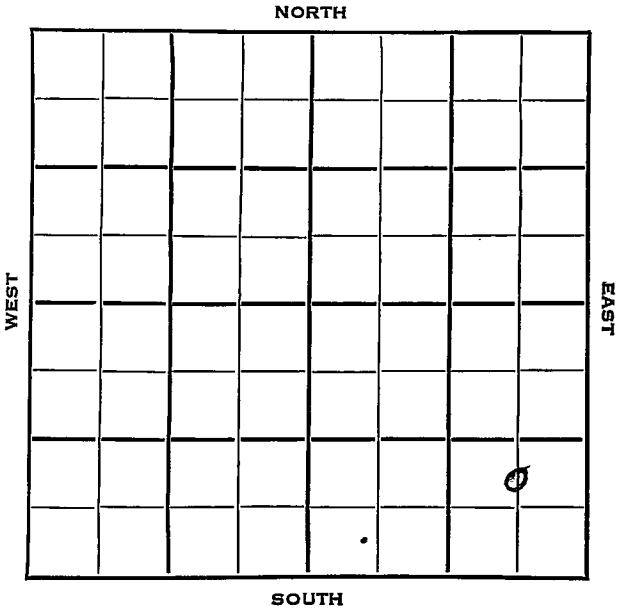



1954

Information brought forward.

5/12

5" @ 4289'

CO to 4307'

PB 4295'

sd-frac.

Comp 40 bopd 120 bw.

**COMPLETED**





Kansas

Map No. \_\_\_\_\_ Sec. 30 Twp. 31 R. 11W

Well No. 4 Schartz "A"

Aylward Drlg. Company

**CORRECTION**

Contractor

C N L SE SE

SECTION PLAT

\_\_\_\_\_ Ft. from N. Line

990 Ft. from S. Line

660 Ft. from E. Line

\_\_\_\_\_ Ft. from W. Line

			o

Barber County

Location \_\_\_\_\_

Rig up \_\_\_\_\_

Drilling and Remarks:

Reported  
#1 Schartz

RECORD

Cased \_\_\_\_\_ in., \_\_\_\_\_ ft.

Sand \_\_\_\_\_

Gas \_\_\_\_\_

Oil \_\_\_\_\_

Total Depth \_\_\_\_\_

PRODUCTION

1st 24 hrs. Nat. \_\_\_\_\_

1st 24 hrs. after shot \_\_\_\_\_

Gas \_\_\_\_\_ Cu. Ft.

Dry Hole \_\_\_\_\_

Abandoned \_\_\_\_\_

Date

MAR 24 1954

J. G. McGEHEE

19

Scout

Scout Cards  
 Land Small Map  
 Land Wall Map  
 Tracings  
 France Map  
 Plans Map  
 Misc.

*mm*

*3*

MAR 26 1954



MAY 1 1922

Scout Cards .....	
Land Small Map .....	
Land Wall Map .....	
Tracings .....	
France M'p .....	
Pierce Map .....	
Misc. ....	

Orig. Date