


Barber

Section 30 Township 31 Range 11-W

Well No. #1 Williams

Company Jim Davis

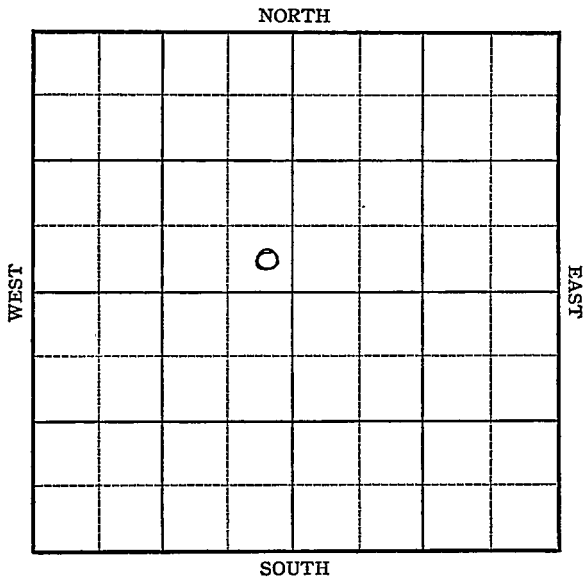

Sec. 30 Twp. 31 R. 11-W

Well No. #1 Williams Farm

Jim Davis Company


 Ft. from N. Line

330 Ft. from S. Line

330 Ft. from E. Line

 Ft. from W. Line

Elev. 1532

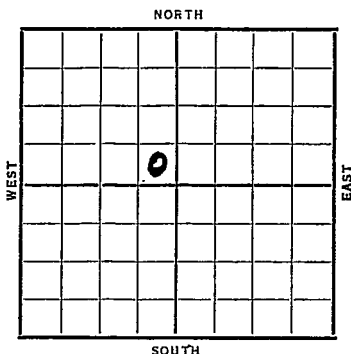

Date	REPORT
1937	
11/17	Ponds.
11/26	R. R.
12/3	12" @ 119'. WOC.
12/10	Drlg. 2150'.
12/17	Drlg. 3285'.
12/24	Chat 4270 ⁴²⁸⁰ '. T.D. 4275'.
	No shows rept.
12/30	T. Chat 4280". (Corrected)
	7" @ 4274'.
	At 4283". 1½ M gas.
	T.D. 4299'.
	Filled up & flowed in 2½ hrs.
	No estimate . (Tel)
1938	
1/7	" " "
1/12	Chat 4280-99 Flow 137 bbls. 1st 4 hrs
	Flow 73 bbls. next 4 hrs.
	Potential 429 bbls. Will run rods and
	retake potential (Tel)

OVER

1938

1/19

7" @ 4274'.

Chat 4280' (Corrected)

T.D. 4299'.

Flowed 137 bbls. 4 hrs & 73 bbls
4 hrs.

Potential 429 bbls.

COMPLETED

1/19/38

Map No. 61 Sec. 30 Twp. 31 R. 11W

Well No. 1 Williams

Jim Davis Company

Contractor

FIRST REPORT

SECTION PLAT

SE NW

_____ Ft. from N. Line

330 Ft. from S. Line

330 Ft. from E. Line

_____ Ft. from W. Line

Location _____

Rig up _____

Drilling and Remarks:

Ponds

RECORD

Cased _____ in., _____ ft.

Sand _____

Gas _____

Oil _____

Total Depth _____

PRODUCTION

1st 24 hrs. Nat. _____

1st 24 hrs. after shot _____


Gas _____ Cu. Ft.

Dry Hole _____

Abandoned _____

Date

NOV 17 1937 19 H. D. Hatfield Scout

 

Paul
Joe
Joe

Barber

KANSASMap No. 61 Sec. 30 Twp. 31 R. 11WWell No. 1 WilliamsJim Davis

Company

Contractor

COMPLETED

SE NW

SECTION PLAT

	0		

_____ Ft. from N. Line

330 Ft. from S. Line330 Ft. from E. Line

_____ Ft. from W. Line

Location _____

Rig up _____

Drilling and Remarks:

RECORDCased 7 in., 4274 ft.Sand Chat 4280

Gas _____ (corr)

Oil _____

Total Depth 4299**PRODUCTION**

1st 24 hrs. Nat. _____

1st 24 hrs. after shot _____

Gas _____ Cu. Ft.

Dry Hole _____

Abandoned _____

Date

JAN 19 1938₁₉E. D. Hatfield


Scout

flowed 137/4 + 73/4

POT 429

✓

Jew.

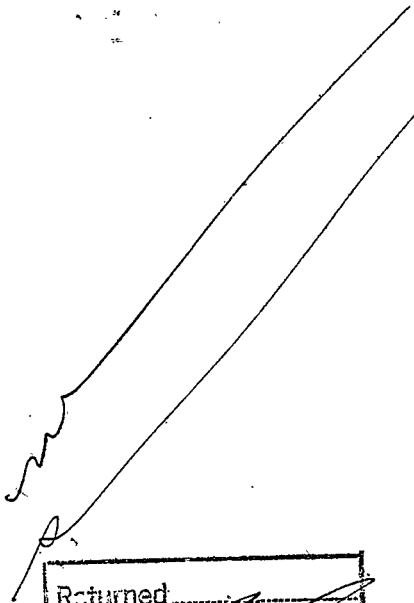

Returned.....	
Cards.....	<i>Paul</i>
Tracing.....	<i>Joe</i>
France Map.....	<i>✓</i>
Scarborough Map.....	<i>Jew.</i>
Mocdy Map.....	
Scarborough Plat Book.....	
Moody Plat Book.....	