

KANSAS

Form 51—5M—7-40—Palace

Barber


Section 30 Township 31 Range 11-W

Well No. #2 Williams

Company J. Davis et al

Whelan Pool

NORTH

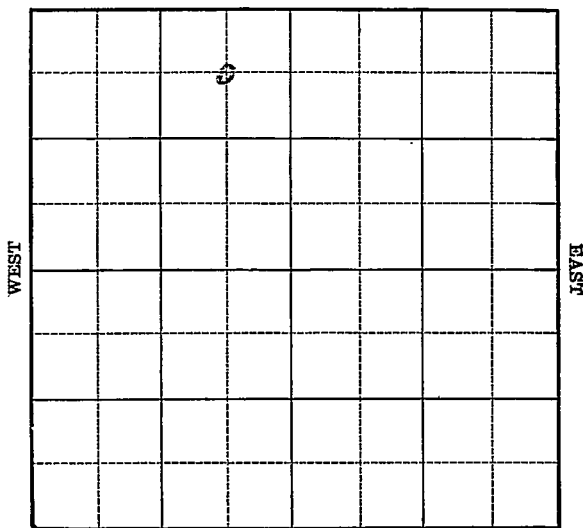

SOUTH

1940

12/11

Chat. 4314'

5" - 4314'

T.D. 4697'

Viola 4565'

Shot 40 qts. 4317-33'

P.B. 4345'

Potential 516 bbls., pump,

31.5 Gravity

COMPLETED

Map No. 61 Sec. 30 Twp. 31 R. 11WWell No. 2 WilliamsJ. Davis etal

Company

Contractor

FIRST REPORT

C NE NW

660 Ft. from N. Line Ft. from S. Line660 Ft. from E. Line Ft. from W. Line

SECTION PLAT

	0		

WHELAN POOL

Location Rig up

Drilling and Remarks:

ROG

RECORD

Cased in., ft.Sand Gas Oil Total Depth

PRODUCTION

1st 24 hrs. Nat. 1st 24 hrs. after shot Gas Cu. Ft.Dry Hole Abandoned

Date

SEP 18 1940 19

S. J. LEWIS Scout

Misc. Small Maps.....
Cards.....
Tracing.....
France Map.....
Scarborough Map.....
Moody Map.....
Geological Dept.
Moody Flat Book

Map No. 61 Sec. 30 Twp. 31 R. 11WWell No. 2 WilliamsJ. Davis etal

Company

Contractor

COMPLETED

C NE NW

660 Ft. from N. Line

Ft. from S. Line

660 Ft. from E. Line

Ft. from W. Line

WHELAN POOL

SECTION PLAT

	o		

Location _____

Rig up _____

Drilling and Remarks:

*Cha 4314**5' @ 4314**Via 4565.**409 to 4317-23**PA. 4345.**Pump 516 Pa X**31.5 Hr.***RECORD**

Cased _____ in., _____ ft.

Sand _____

Gas _____

Oil _____

Total Depth 4697**PRODUCTION**

1st 24 hrs. Nat. _____

1st 24 hrs. after shot _____

Gas _____ Cu. Ft.

Dry Hole _____

Abandoned _____

Date

DEC 11 1940S. J. LEWIS Scout

Misc Small Maps	RM
Cards	RM
Tracing	RM
France Map	RM
Scarborough Map	RM
Moody Map	
Geological Dept.	
Moody Plat Book	