


DX 78-1

Harper KANSAS

Section 30 Township 31 Range 9W

Well No. 1 Best

Company Petroleum, Inc.

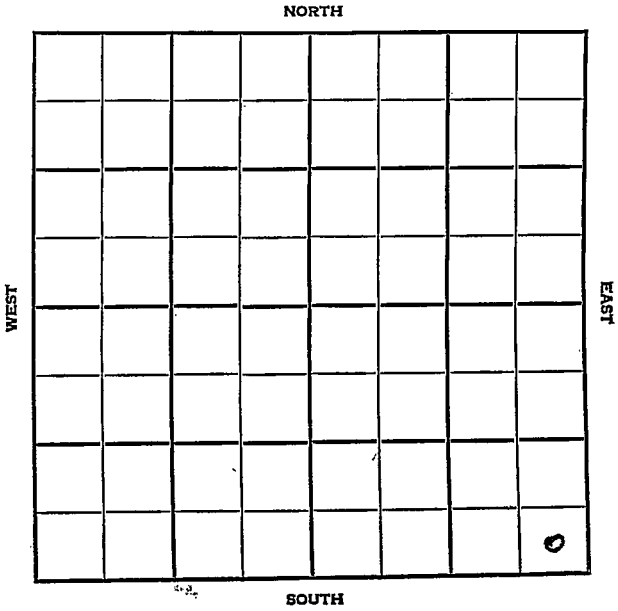

SEC.	TWP.	R.
30	31	9W

WELL NO. **I Best** FARM

COMPANY **Petroleum, Inc.**

CONTRACTOR **Dudley & Heath**


**Wildcat**

\_\_\_\_\_ Ft. from N. Line

**330** \_\_\_\_\_ Ft. from S. Line

**330** \_\_\_\_\_ Ft. from E. Line

\_\_\_\_\_ Ft. from W. Line

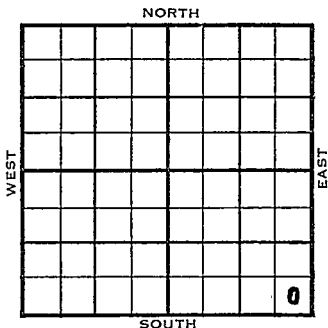

SE SE SE

1955	ELEVATION <b>1621'</b>	REPORT
------	---------------------------	--------

4/20 Location

5/25 Heeb 3529; Doug 3580; Lsg 3717;  
 BKC 4235; Miss Chat 4409; Miss Ls  
 4441; Kind 4616; Viola 4720; Simp  
 4780; Arb 4920;  
 TD 4960; 8 5/8" 265;  
 DST 4411-35 open 30 min, weak blo 4  
 min, rec 15' mud, 715#; DST 4475-4800  
 open 1 hr rec 3850' sw; log  
 D&A

**ABANDONED**

