

Stevens


KANSAS

FORM 51 25M 3-49 PETROL

Section 30 Township 31 Range 37W

Well No. #1 Musgrove

Company Hugoton Prod.

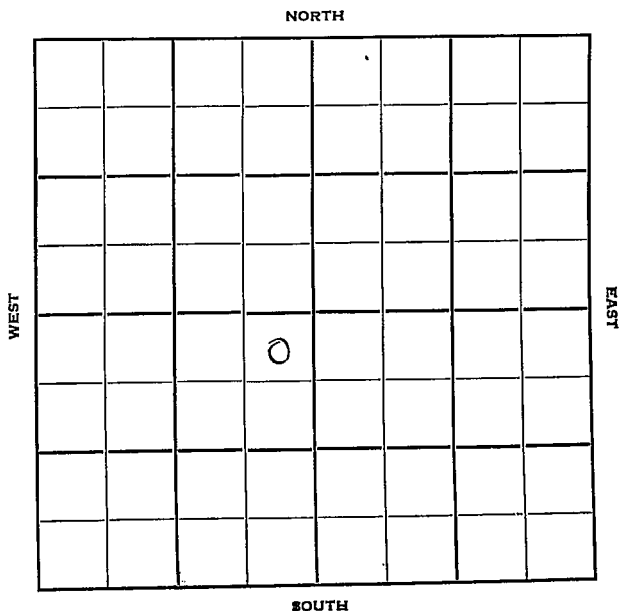

Stevens

KANSAS

Sec. 30 Twp. 31 R. 37W

Well No. #1 Musgrove Farm

Hugoton Prod. Company

Hugoton Pool Contractor


Ft. from N. Line

2445' Ft. from S. Line

Ft. from E. Line

2500' Ft. from W. Line

NE NE SW

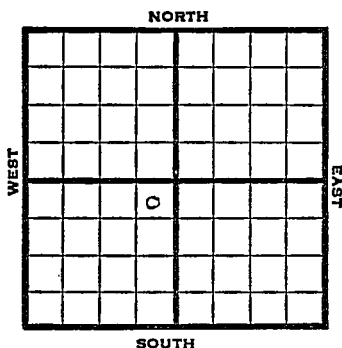

1950 Elev 3135

REPORT

8/30 Location

10/25 Spud 9-2-50

10" @ 567

7" @ 2470

TD 2720

Hol 2433

Krider 2494-2553

Towanda 2631-77

17000 total acid

Comp 34,899,000 gas

TD 2720

Completed


COMPLETED

Her 2475

Win 2570

Ft. Riley 2683

J. E. TYRA

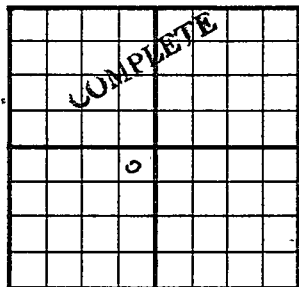County Stevens State KansasSec. 30 (Blk.) 31 (Sur.) 37W Map No.Operator Hugoton Prod.Well No. 1 Farm MusgroveElev. 3135 Location NE NE SW2445 Ft. From S Line SW2500 Ft. From W Line Quarter1st. ReportCompletion OCT 25 1950Remarks Hugoton PoolSpudding Date 9-2-50Drlg. Data Gas well TD 272010" @ 567 7" @ 2470 TD 2720Hol. 2433 Her. 2475 Krider 2494-2553Win. 2570 Towanda 2631-77 Ft. Riley 268317000 total acid Comp. 34,899,000 gas

J. E. TYRA