

KANSAS


Seward

Section 30 Township 31 Range 33WWell No. 1 Beatty "G"Company Terminal Service
Cities Service

Hugoton

NORTH

WEST

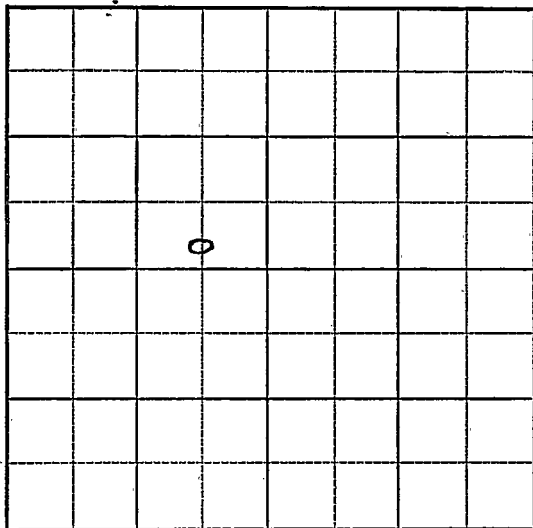

EAST

SOUTH

Seward KANSAS ✓

Sec. 30 Twp. 31 R. 33W

Well No. #1 Beatty "C" Farm
Terminal Service
Cities Service Company

Hugoton Pool (Lohman & Johnson Cont.)


 Ft. from N. Line

350' Ft. from S. Line

600' Ft. from E. Line

 Ft. from W. Line

C S L SE NW

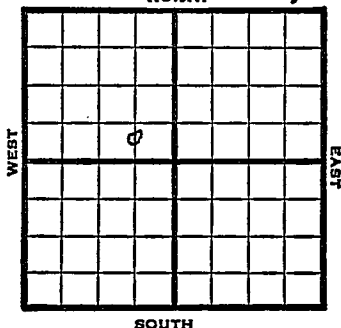

1949	Elev 2846'	REPORT
8/10	Location	
8/17	"	
8/24	"	
8/31	8" @ 520'	
	Drlg 1065'	
9/7	TD 2732'	
	5" @ 2731'	
9/14	"	
9/21	270 shots 2530-2648	
	Acid 13,000	
9/28	"	
10/5	"	
10/12	"	
10/19	TD 2732'	
	5" @ 2731'	
	Perf	
	13000acid	
	11,300,000 Gas	
	422# R Pr.	
	Comp	
	COMPLETED	

Map No. _____ Sec. 30 Twp. 31 R. 3 3W

Well No. 1 Beatty "C"

Cities Service Company

Lohman & Johnson Contractor

C S L SE NW


FIRST REPORT
SECTION PLAT

_____ Ft. from N. Line

350 _____ Ft. from S. Line

600 _____ Ft. from E. Line

_____ Ft. from W. Line

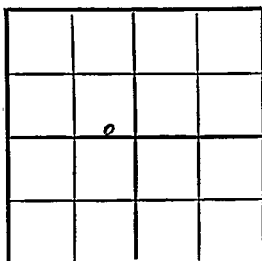

Seward County

RECORD

Location X

Cased _____ in., _____ ft.

Rig up

Sand _____

Drilling and Remarks:

Gas _____

Oil _____

Total Depth _____

PRODUCTION

1st 24 hrs. Nat. _____

1st 24 hrs. after shot _____

Gas _____ Cu. Ft.

Dry Hole _____

Abandoned _____

Date

AUG 10 1949 19

S. J. LEWIS Scout

Map No. _____ Sec. 30 Twp. 31 R. 33W

Well No. 1 Beatty "C"

Terminal Service


Company

CORRECTION

Contractor

C S L SE NW

SECTION PLAT

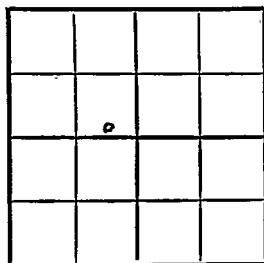

_____ Ft. from N. Line

350 _____ Ft. from S. Line

600 _____ Ft. from E. Line

_____ Ft. from W. Line

Seward County

Location _____

Rig up _____

Drilling and Remarks: _____

Was Cities Service _____

RECORD

Cased _____ in., _____ ft.

Sand _____

Gas _____

Oil _____

Total Depth _____

PRODUCTION

1st 24 hrs. Nat. _____

1st 24 hrs. after shot _____

Gas _____ Cu. Ft.

Dry Hole _____

Abandoned _____

Date

SEP 28 1949

19

S. J. LEWIS Scout

Map No. _____ Sec. 30 Twp. 31 R. 33W

Well No. 1 Beatty "C"

Terminal Service _____ Company _____

COMPLETE

Contractor _____

C S L SE NW


E 1.2846
SECTION PLAT

_____ Ft. from N. Line

350 Ft. from S. Line

600 Ft. from E. Line

_____ Ft. from W. Line

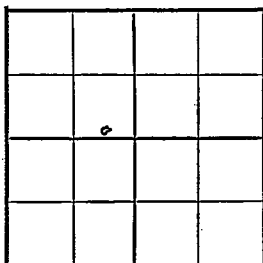

Seward County

Location _____

Rig up _____

Drilling and Remarks:

5" C2731

Perf.

13000000 Cu

11,300,000 Gas

432 R/F

RECORD

Cased _____ in., _____ ft.

Sand _____

Gas _____

Oil _____

Total Depth 2222

PRODUCTION

1st 24 hrs. Nat. _____

1st 24 hrs. after shot _____

Gas _____ Cu. Ft.

Dry Hole _____

Abandoned _____

Date _____

OCT 19 1949 19

S. J. LEWIS Scout