


Section 30 Township 31 Range 14-W

Well No. 1 Oldfather

Company Amerada

Skinner Pool

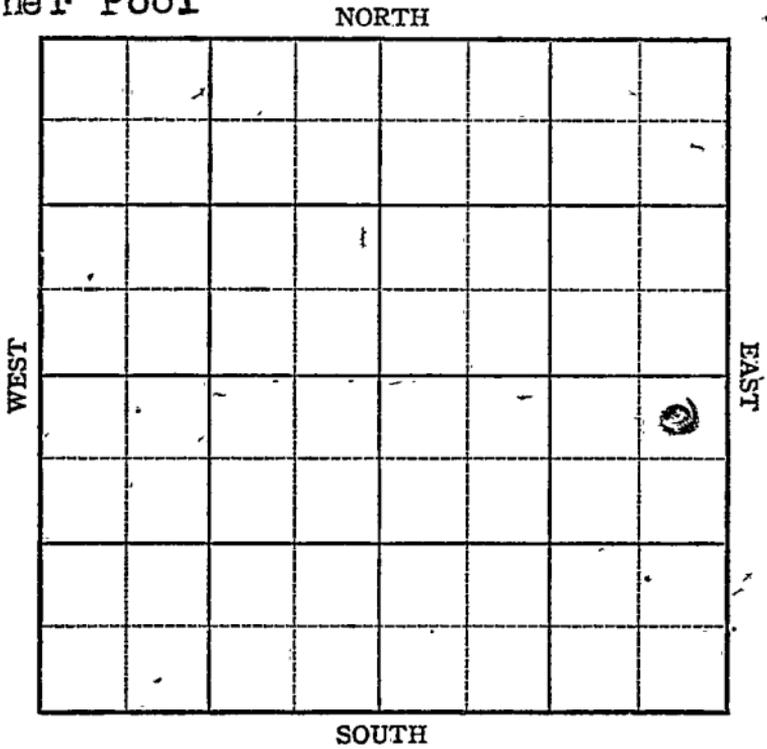

Sec. 30 Twp. 31 R. 14-W

Well No. #1 Oldfather Farm

Amerada Company

Skinner Pool


330 Ft. from N. Line

_____ Ft. from S. Line

330 Ft. from E. Line

_____ Ft. from W. Line

NE SE

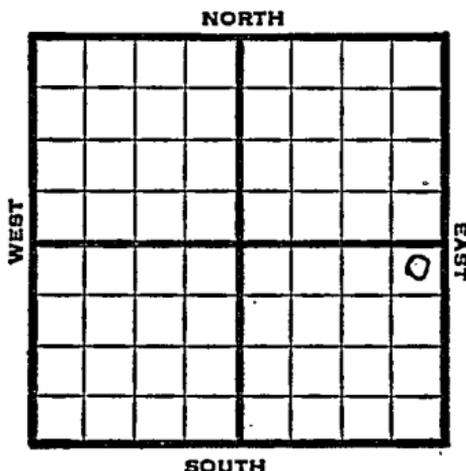

1947

Elev. 1844'

REPORT

7/2 Location

7/8 Drlg 327'

7/16 13" @ 323'
Drlg 3185'

7/22 Lansing 4012'
Drlg 4478'

7/29 Viola 4634'
5" @ 4636'
TD 4637'
RUST

8/6 Viola 4634'
5" @ 4636'
500 acid.
Bonn Pot 3976'
Gr. 39.9
T.D. 4638'
Completed

COMPLETED

Map No. _____ Sec. 30 Twp. 31 R. 14W

Well No. 1 Oldfather

Amerada _____ Company

FIRST REPORT _____ Contractor

NE SE


SECTION PLAT

330 Ft. from N. Line

_____ Ft. from S. Line

330 Ft. from E. Line

_____ Ft. from W. Line

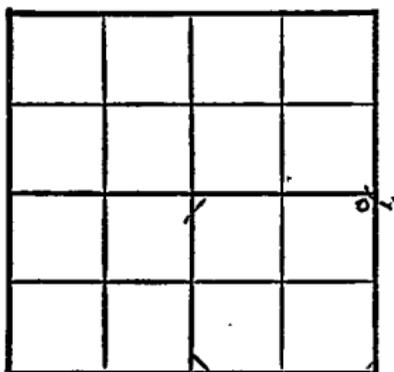

Barber County

Location X

Rig up _____

Drilling and Remarks:

RECORD

Cased _____ in., _____ ft.

Sand _____

Gas _____

Oil _____

Total Depth _____

PRODUCTION

1st 24 hrs. Nat. _____

1st 24 hrs. after shot _____


Gas _____ Cu. Ft.

Dry Hole _____

Abandoned _____

Date

JUL 2 1947 19 _____ S. J. LEWIS Scout

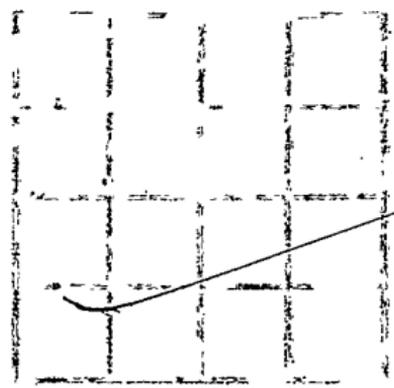


- Misc. Small Maps
- Cards
- Tracing
- France Map
- Scarborough Map
- Pierce Map
- Geological Dept.
- Pierce Plat. Book

25/10 4

Kansas Skinner Pool

Map No. 93 Sec. 30 Twp. 31 R. 14W

Well No. 1 Oldfather

Amerada Company

COMPLETE Contractor

NE SE

E 1, 1803
SECTION PLAT

			4

330 Ft. from N. Line

_____ Ft. from S. Line

330 Ft. from E. Line

_____ Ft. from W. Line

Barber County

Location _____

Rig up _____

Drilling and Remarks:

Vestcut 634
5" @ 4636
500 acid
Bonn P 48976
39 2/4

RECORD

Cased _____ in., _____ ft.

Sand _____

Gas _____

Oil _____

Total Depth 4638

PRODUCTION

1st 24 hrs. Nat. _____

1st 24 hrs. after shot _____

Gas _____ Cu. Ft.

Dry Hole _____

Abandoned _____

Date

AUG 6 1947 19

S. J. LEWIS Scout

Wells

W

Misc Smz.	✓
Cards	✓
Tracing	✓
France Map	✓
Scarborough Map	✓
Pierce Map	✓
Geological Dept.	
Pierce Plat Book	