KANSAS

Barber

FORM 51 10M 12-46 PETROL

Section 30 Township 31 Range 14W

Well No. 2 Oldfather

Company Amerada

Skinner

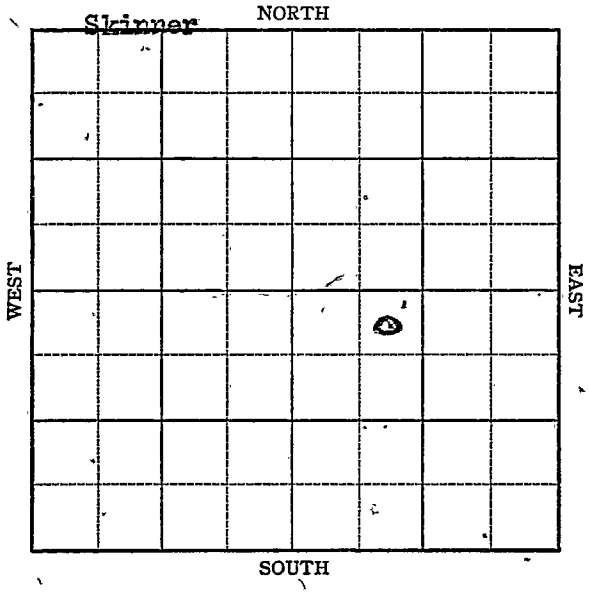

FORM 252-A
5M 12-46 PETROL

KANSAS Barber

Sec. 30 Twp. 31 R. 14W

Well No. #2 Oldfather Farm

Amerada Company

Skinner

330 Ft. from N. Line

Ft. from S. Line

Ft. from E. Line

990 Ft. from W. Line

NE NW SE

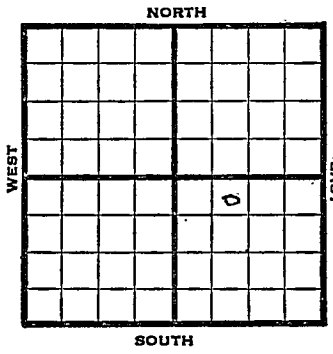

1947	Elev. 1823 REPORT [redacted]
8/6	RUR
8/13	8" @ 309 Drlg. 1729'
8/20	Drlg 3580'
[redacted]	[redacted]
8/27	Maquoketa 4610' TD 4613' 5" @ 4611 RUST
9/3	"
9/10	4621 TD 500 Acid swb 1 fluid PH 4 hrs 5% W

OVER

1947

9/17 Maguaketa 4610'
5" @ 4611'
500 Acid
Pump 35 oil & 5% W Pot
Gr. 41°-
Total Depth 4621'

COMPLETED

Form 26 200 Bks. 10-46 Petrol

Kansas Skinner

Map No. Sec. 30 Twp. 31 R. 14W

Well No. 2 Oldfather

Amerada Company

FIRST REPORT Contractor

NE NW SE

330 Ft. from N. Line

Ft. from S. Line

Ft. from E. Line

990 Ft. from W. Line

SECTION PLAT

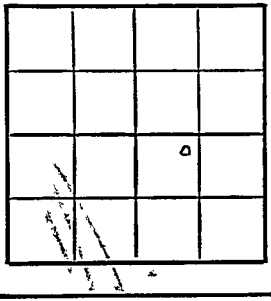

Barber County

Location

Rig up

Drilling and Remarks:

RUR

RECORD

Cased in., ft.

Sand

Gas

Oil

Total Depth

PRODUCTION

1st 24 hrs. Nat.

1st 24 hrs. after shot

Gas Cu. Ft.

Dry Hole

Abandoned

Date

AUG 6 1947 19 S. J. LEWIS Scout

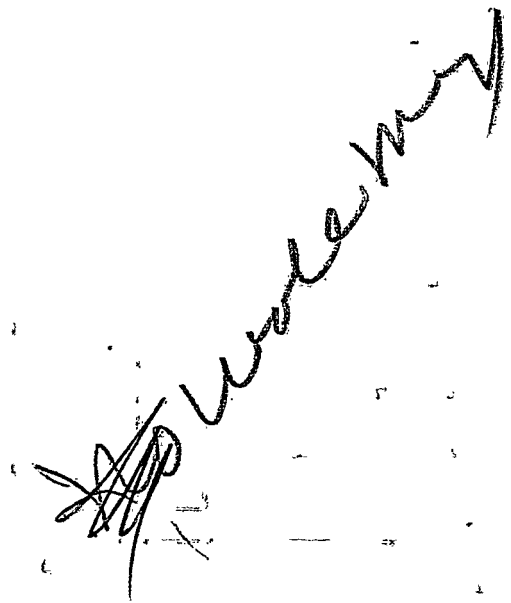

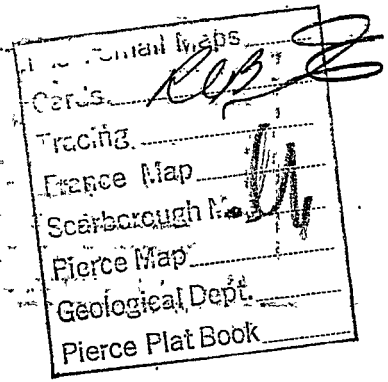
Cards
Tracing
Scarborough
Pierce Map
Geological Dept.
Pierce Plat Book

Form 26 200 Bks. 10-46 Petrol

Kansas

Skinner Pool

Map No. 93 Sec. 30 Twp. 31 R. 14W

Well No. 2 Oldfather

Amerada Company

COMPLETE Contractor

NE NW SE

El. 1823

SECTION PLAT

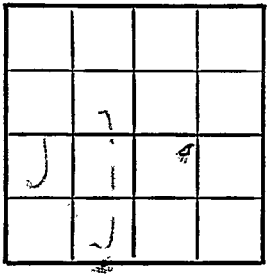

330 Ft. from N. Line

Ft. from S. Line

Ft. from E. Line

990 Ft. from W. Line

Barber County

Location

Rig up

Drilling and Remarks:

Waquoketa 4610

5½" @ 4611

500 cc acid

Pump 35 oil +

5 gal RD.

RECORD

Cased in, ft.

Sand

Gas

Oil

Total Depth 4621

PRODUCTION

1st 24 hrs. Nat.

1st 24 hrs. after shot

Gas Cu. Ft.

Dry Hole

Abandoned

Date

SEP 17 1947 19

S. J. LEWIS Scout

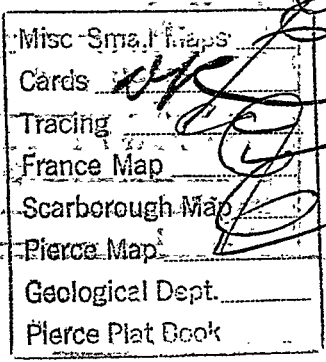
Misc Sma. Maps
Cards
Tracing
France Map
Scarborough Map
Pierce Map
Geological Dept.
Pierce Plat Book