

KANSAS

FORM 51 5M 10-41 PETROL


Barber

Section 30 Township 31 Range 15-W

Well No. #1 Welsh

Company Great Lakes Carbon

Wildcat

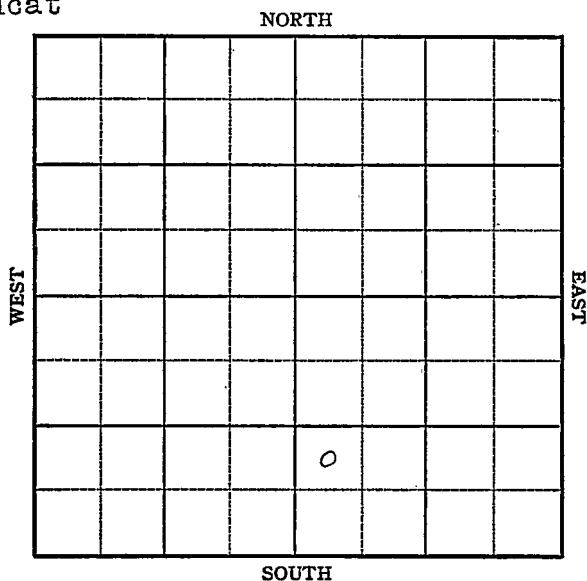


Sec. 30 Twp. 31 R. 15WWell No. 1 Welsh FarmGreat Lakes Carbon Company

(Wildcat)

 Ft. from N. Line990 Ft. from S. Line Ft. from E. Line330 Ft. from W. Line

Elev. 1969

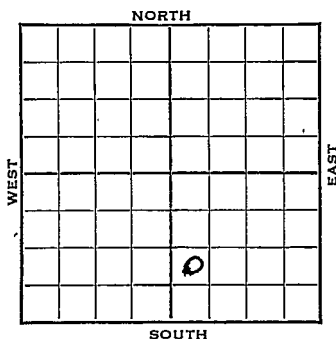

1942	REPORT
9/30	MIM
10/7	Rotary
10/14	10" @ 240 Anhy 890 Drlg. 1100
10/21	Drlg 3240'
10/28	Topeka 3410' Douglas 4234-39 S.O. BE. SD Lans 4249 Drlg. 4269
11/4	TD 4690 Los & circulation
11/11	Viola 4598 Drlg. 5108'
11/18	Simp 5182 Arp 5288 TD 5305 PB to Douglas
11/24	SD
12/2	PB 4249 7" @ 4235 1200' oil 500', water 16 hrs.
12/9	Swb 80 oil & 20 wtr. a day.
12/16	SD
12/22	Pump 85 bbls oil plus 25 bbls water in 24 hrs.

OVER

1942

12/29

Lans 4249

Douglas 4234

Arb. 5288

T.D. 5303'

PB 4235'

7" @ 4235'

Pump 85 bbls. oil plus 24 bbls water.

Pot.

Gravity 35.2

COMPLETED

Barber

KANSAS

Map No. 93 Sec. 30 Twp. 31 R. 15WWell No. 1 WelshGreat Lakes Carbon Company

Contractor

NW SW SE

SECTION PLAT

		o	

_____ Ft. from N. Line

990 Ft. from S. Line

_____ Ft. from E. Line

330 Ft. from W. Line

WILDCAT

Location _____

Rig up _____

Drilling and Remarks:
mm

RECORD

Cased _____ in., _____ ft.

Sand _____

Gas _____

Oil _____

Total Depth _____

PRODUCTION

1st 24 hrs. Nat. _____

1st 24 hrs. after shot _____

Gas _____ Cu. Ft.

Dry Hole _____

Abandoned _____

Date FIRST REPORTS

SEP 30 1942 19

S. J. LEWIS

Scout

Misc Small Maps *RAY*
 Cards *RAY*
 Tracing *RAY*
 France Map *RAY*
 Scarborough Map *RAY*
 Moody Map *RAY*
 Geological Dept.
 Moody Flat Book

KANSAS

Barber

Map No. 93 Sec. 30 Twp. 31 R. 15WWell No. 1 Welsh

Great Lakes Carbon Company

~~COMPLETED~~ Contractor

NW SW SE

SECTION PLAT

		6	

Ft. from N. Line

990 Ft. from S. Line

Ft. from E. Line

330 Ft. from W. Line

WILDCAT

Location

Rig up

Drilling and Remarks:

*Lone 4249**Douglas 4234**Ac 5288**PB 4235**2" 4235**Pump Soil + 24 H₂O**P.S.**35-2 SW*

RECORD

Cased _____ in., _____ ft.

Sand _____

Gas _____

Oil _____

Total Depth 5305

PRODUCTION

1st 24 hrs. Nat. _____

1st 24 hrs. after shot _____

Gas _____ Cu. Ft.

Dry Hole _____

Abandoned _____

Date

DEC 29 1942

19

S. J. LEWIS Scout

Misc Small Maps *One*
Cards *Best*
Tracing *MB*
France Map *✓*
Scarborough Map *✓*
Moody Map *✓*
Cenological Dept. *✓*
Moody Flat Book *✓*