

Sumner

KANSAS


SECTION 30 TOWNSHIP 31S RANGE 4W

WELL NO. #1 Argonia Baptist Church

COMPANY C R A

NORTH

C SW NW

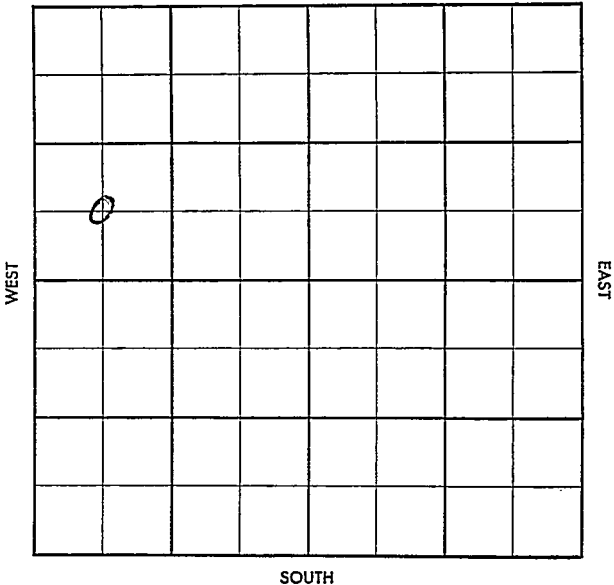

~~44-38861-28~~ Fact. ~~28~~

WILDCAT

S-513-B

County Sumner Elev. _____
Sec. 30 Twp. 31 Rge. LW
Company C R A
Farm Name Argonia Baptist Church No. 1

TOPS	DEPTH	LOG	DATUM
Anh.			
Tp.			
H.			
Tr.			
Dg.			
B. L.			
L.			
K.C.			
B.K.C.			
Ce.			
C.			
M.			
M.			
K.			
Mz.			
Mq.			
V.			
S.			
S.			
A.			
R.			
Pf.			
G.			
T.D.			

Loc. in Sec.

C SW NW

Geol.

Contr.

Pool

Wildcat

6
JUN 14 1958
FIRST REPORT

Date Comm. _____ Carter & Kirby - OHIO - DHM

Location

9

USE:

INC.

20

1.

1

Twp. ~~X~~ Pool ~~X~~
 Co. ~~X~~ Facet ~~X~~

S-513-B

Co.

County Sumner Elev. 13030 ~~1306~~
 Sec. 30 Twp. 31 Rge. LW
 Company C R A
 Farm Name Argonia Baptist Church No. 1

TOPS	DEPTH	LOG	DATUM
Anh.			
Tp.	<u>2563</u>		
H.	<u>2914</u>	<u>2916</u>	
Tr.			
Dg.	<u>2998</u>	<u>3012</u>	
B.L. <u>5701</u>	<u>3235</u>	<u>3237</u>	
L.			
K.C.	<u>3514</u>	<u>3516</u>	
B.K.C.	<u>3754</u>	<u>3754</u>	
Ce. <u>9125m</u>	<u>3925</u>	<u>3826</u>	
C.			
M. <u>2100</u>	<u>4141</u>		
M. <u>Li</u>	<u>4180</u>	<u>4172</u>	
K.	<u>4498</u>	<u>4510</u>	
Mz.			
Mq.			
V.			
S. <u>5d</u>	<u>4601</u>	<u>4602</u>	
S. <u>135d</u>	<u>4659</u>		
A. <u>4727</u>	<u>4727</u>	<u>4727</u>	
R.			
Pf.			
G.			
T.D.	<u>4766</u>	<u>4766</u>	

Loc. in Sec. C SW NW

Geol.

Contr.

Pool

Wildcat

ABANDONED

JUN 11 '58

Date Comm. 5-19-58 Kirby FO
Carter & Ohio DHM

Location MAY 21 '58 MAY 23 '58 8'325/250

0 3545 JUN 3 '58 0 297 JUN 11 '58

0 4602-4610 1hr 3865' SW

BHP 1820-1700/20 FP 820-1660

Log

DOA

Lsc.

No.

Sec.

T.

R.