


Section 30 Township 31 Range 8W
Well No. 1 Washbon
Company British-American

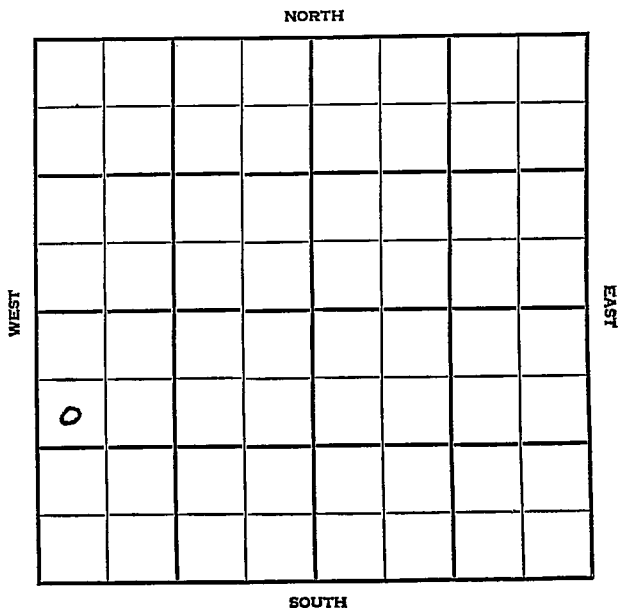

Harper

KANSAS

SEC.	TWP.	R.
30	31	8W

WELL NO.

#1 Washbon

FARM

COMPANY



British American

CONTRACTOR

Deceum Drlg.

S Grabs Pool

NORTH

990

Ft. from N. Line

Ft. from S. Line

Ft. from E. Line

330

Ft. from W. Line

WEST									EAST
SOUTH									

SW NW SW

	ELEVATION	REPORT
1954	1582'	

10/27 R U R
 3/16 Spud 10-25-55, Oil Well, TD 4405
 10 3/4 @ 279, Doug 3490, Lans
 3665, kc 3895, Miss 4371,
 DST 4389-4402, open 1 hr, gas in
 9 min, Rec 40' MO 440' oil, 120'
 SW, off TD 4405 5" @ 4390 CO
 to 4405, S/17 1/2 BO 3 hr.
 S/27 1/2 BO 10 hr P/3 BOPH 12%
 wtr. Pump 45 BOPD 5 Bw
 P/18 BO 10 BW
 Comp 22 BOPD 12 BW

COMPLETED

County Harper State Kansas

Sec. **30** (Blk. Twp.) **31** (Sur. Rge.) **8W** Map No.,

Operator **British American**

Well No. 7 Farm Washbon

Elev.	Location	SW	NW	SW
-------	----------	----	----	----

0

FIRST REPORT

990 Ft. From N Line SW

330 Ft. From ~~V~~ Line Quarter

1st. Report OCT 27 1954

Completion

Remarks

Deceum Drlg. - Contr.

Spudding Date _____

Drig. Data S. Grabs Pool

RUR

FABEN GILSTRAD

County Harper State Kansas
 Sec. 30 (Blk. 31 (Sur. 8W Map No.
 (Twp.) (Rge.)
 Operator British American
 Well No. 1 Farm Washbon
 Elev. 1582 Location SW NW SW

990 Ft. From N Line SW
330 Ft. From W Line Quarter
 1st. Report
 Completion MAR 16 1955
 Remarks S. Grabs Pool
Big X Drlg. - Contr.
 Spudding Date 10-25-54

Drlg. Data Oil well TD 4405
10 3/4" @ 279 Doug. 3490 Lans. 3665
KC 3895 Miss. 4371 DST 4389-4402
open 1 hr. gas in 9 min. Rec. 40' mo
440' oil 120' sw 0# TD 4405
5" @ 4390 CO to 4405 S/ 17 1/2 bo 3 hr.
S/ 27 1/2 bo 10 hr. P/ 3 boph 12% wtr.
Pump. 45 bopd 5bw P/ 18 bo 10 bw
Comp. 22 bopd 12 bw

FABEN GILSTRAP