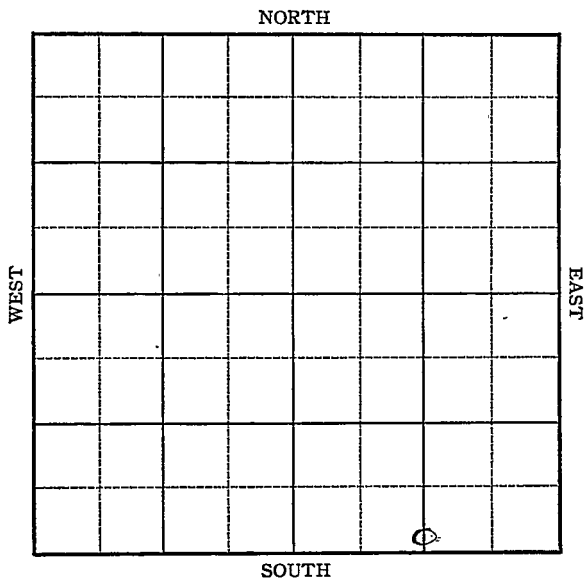


Barber

O.W.D.D

KANSAS

Section 30 Township 31 Range 11 WWell No. #2 Schwartz (Swartz)Company ~~AYKWARD OIL CO.~~
Olson et al

1937

12/15 7" @ 4265'.

Miss. 4268'.

T.D. 4294'.

Potential 821 bbls.

33.1 gravity.

COMPLETED

1954

10/20

OWDD for SWD

Miss 4272'

6" @ 4272'

OTD 4294'

DD

Kh. 4417', Viola 4541', Simp 4628',

Arb. 4760'

Drlg. 5560'.

11/23

SWD Well

TD 5170'

Miss 4272'

6" @ 4272'

OTD 4294' DD Kh, 4417' Viola 4541'

Simp 4628' Arb. 4760'

TD 5170'

5" @ 4759'

Comp for SWD Well.

O. W. D. D

ABANDONED


FABEN GILSTRAP

OCT 22 1954

Scout Cards	10
Land Small Map	
Land Wall Map	33
Tracings	
France Map	
Pierce Map	
Misc.	

Drig. Data

O. W. D. D

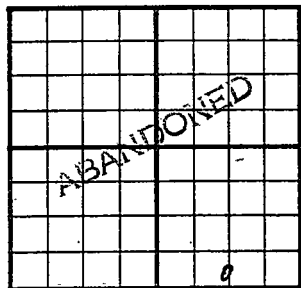County Barber State KansasSec. 30 (Blk. Twp.) 31 (Sur. Rge.) 11W Map No.Operator Aylward Drlg.Well No. 2 Farm SwartzElev. 1517 Location C S $\frac{1}{2}$ S $\frac{1}{2}$ SE330 Ft. From S Line SE1320 Ft. From E Line Quarter

1st. Report

Completion NOV 23 1954Remarks OWDD for SWDSpudding Date O. W. D. DDrlg. Data SWD well TD 5170Miss. 4272 6" @ 4272 OTD 4294 DDKh. 4417 Viola 4541 Simp. 4628Arb. 4760 TD 5170 5" @ 4759Comp. for SWD well

FABEN GILSTRAP

1


[illegible]

Barber KANSASMap No. 61 Sec. 30 Twp. 31 R. 11WWell No. 2-SchwartzOlson et al Company

Contractor

FIRST REPORT

SECTION PLAT

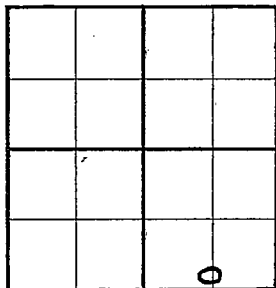

_____ Ft. from N. Line

330 Ft. from S. Line1320 Ft. from E. Line

_____ Ft. from W. Line

Location _____

Rig up _____

Drilling and Remarks:

Roty Rig

RECORD

Cased _____ in., _____ ft.

Sand _____

Gas _____

Oil _____

Total Depth _____

PRODUCTION

1st 24 hrs. Nat. _____

1st 24 hrs. after shot _____

Gas _____ Cu. Ft.

Dry Hole _____

Abandoned _____

Date

SEP 22 1937

19

H. D. Hatfield Scout

check 100 E. 100
C. 100 E. 100

Check section

Advise if O.K.

Sam

Sam:

Section 30 is O.K.
This lease formerly belonged
to Vaccaro Corp.

Returned

Cards

Tracing

France Map

Scarborough Map

Moody Map

Scarborough Plat Book

Moody Plat Book

Barber KANSAS

Map No. 61 Sec. 30 Twp. 31 R. 11WWell No. 2 SchwartzOlson et al Company

Contractor

COMPLETED

SECTION PLAT

C S L SE

 Ft. from N. Line330 Ft. from S. Line1320 Ft. from E. Line Ft. from W. Line

			○

Location Rig up

Drilling and Remarks:

POT-821

grav. 33.1

RECORD

Cased 7 in., 4265 ft.Sand MISS 4268Gas Oil Total Depth 4294

PRODUCTION

1st 24 hrs. Nat. 1st 24 hrs. after shot Gas Cu. Ft.Dry Hole Abandoned

Date

DEC 15 1937 19H. D. Hatfield Scout

1951

Returned

Cards

Trac

Trac

Con

Trac

Sender

Wood

[Handwritten signature]

[Handwritten signature]
[Handwritten signature]
[Handwritten signature]