

# State Geological Survey

## WICHITA, BRANCH

### KANSAS DRILLERS LOG

**URGENT**  
Kans. Geol. Survey request  
samples on this well.

API No. 15 — 175 — -20-289 20,292  
County Number

Operator

Imperial Oil Company

Address

720 Fourth Financial Center Wichita, Kansas 67202

Well No.

"A" #1-25

Lease Name

Elliott

Footage Location

1980

feet from (N) ~~XX~~ line

1880

feet from (E) ~~XX~~ line

Principal Contractor

Sage Drilling, Inc.

Geologist

Richard Roby

Spud Date

6-25-76

Total Depth

5890

P.B.T.D.

5882

Date Completed


7-10-76

Oil Purchaser

S. 25 T. 31 R. 31 E.  
100' East of  
Loc. C SW NE

County Seward

640 Acres  
N

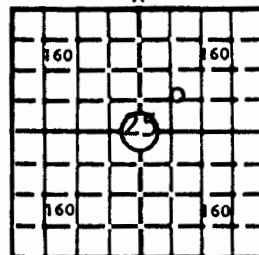

Locate well correctly

Elev.: Gr. 2781

DF 2792 KB

### CASING RECORD

Report of all strings set — surface, intermediate, production, etc.

Purpose of string	Size hole drilled	Size casing set (in O.D.)	Weight lbs./ft.	Setting depth	Type cement	Sacks	Type and percent additives
Surf. csg.	12½"	8 5/8"		1702'		750	

### LINER RECORD

### PERFORATION RECORD

Top, ft.	Bottom, ft.	Sacks cement	Shots per ft.	Size & type	Depth interval

### TUBING RECORD

Size	Setting depth	Packer set at			


### ACID, FRACTURE, SHOT, CEMENT SQUEEZE RECORD

Amount and kind of material used	Depth interval treated

### INITIAL PRODUCTION

Date of first production		Producing method (flowing, pumping, gas lift, etc.)			
RATE OF PRODUCTION PER 24 HOURS	Oil  bbls.	Gas  MCF	Water  bbls.	Gas-oil ratio  CFPB	
Disposition of gas (vented, used on lease or sold)			Producing interval (s)		

INSTRUCTIONS: As provided in KCC Rule 82-2-125, within 90 days after completion of a well, one completed copy of this Drillers Log shall be transmitted to the State Geological Survey of Kansas, 4150 Monroe Street, Wichita, Kansas 67209. Copies of this form are available from the Conservation Division, State Corporation Commission, 3830 So. Meridian (P.O. Box 17027), Wichita, Kansas 66217. Phone AC 316-522-2206. If confidential custody is desired, please note Rule 82-2-125. Drillers Logs will be on open file in the Oil and Gas Division, State Geological Survey of Kansas, Lawrence, Kansas 66044.

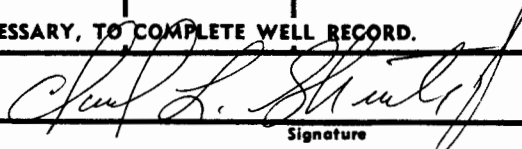Operator <b>IMPERIAL OIL COMPANY</b>		DESIGNATE TYPE OF COMP.: OIL, GAS, DRY HOLE, SWDW, ETC.:																					
Well No. <b>A #1-25</b>	Lease Name <b>Elliott</b>		Dry Hole																				
s <u>25</u> T <u>31</u> R <u>31</u> <sup>EX</sup> <sub>W</sub>																							
<b>WELL LOG</b>		SHOW GEOLOGICAL MARKERS, LOGS RUN, OR OTHER DESCRIPTIVE INFORMATION.																					
Show all important zones of porosity and contents thereof; cored intervals, and all drill-stem tests, including depth interval tested, cushion used, time tool open, flowing and shut-in pressures, and recoveries.																							
FORMATION DESCRIPTION, CONTENTS, ETC.	TOP	BOTTOM	<table border="1" style="width: 100%; border-collapse: collapse;"> <thead> <tr> <th style="padding: 5px;">NAME</th> <th style="padding: 5px;">DEPTH</th> </tr> </thead> <tbody> <tr><td style="padding: 5px;">Heebner</td><td style="padding: 5px;">4249</td></tr> <tr><td style="padding: 5px;">Lansing</td><td style="padding: 5px;">4362</td></tr> <tr><td style="padding: 5px;">Marmaton</td><td style="padding: 5px;">4928</td></tr> <tr><td style="padding: 5px;">Cherokee</td><td style="padding: 5px;">5160</td></tr> <tr><td style="padding: 5px;">Atoka</td><td style="padding: 5px;">5403</td></tr> <tr><td style="padding: 5px;">Morrow</td><td style="padding: 5px;">5458</td></tr> <tr><td style="padding: 5px;">Chester</td><td style="padding: 5px;">5491</td></tr> <tr><td style="padding: 5px;">RTD</td><td style="padding: 5px;">5890</td></tr> <tr><td style="padding: 5px;">LTD</td><td style="padding: 5px;">5882</td></tr>
<p><u>DST #1</u> 5054-5085' 30-60-30-60  IBHP: 1605# FBHP: 1600#  IFP: 34-142 FFP: 132-205  Weak Blow. Rec. 400' mdy salt wtr.</p> <p><u>DST #2</u> 5119-5147' 30-60-60-90  IBHP: 1601# FBHP: 1575#  IFP: 37-101 FFP: 86-163  Very weak blow; rec. 260' mdy SW.</p> <p><u>DST #3</u> 5424-5484' 60-120-180-120  IBHP: 614# FBHP: 552#  IFP: 120-61 FFP: 196-127  Very weak blow, first opening.  Strong blow throughout, 2nd opening.  Rec. 150' mud</p> <p><u>DST #4</u> 5570-5600' 30-60-30-60  IBHP: 48# FBHP: 48#  IFP: 35-68 FFP: 57-39  Very weak blow. Rec. 5' mdy wtr.</p> <p><u>DST #5</u> 5790-5890' 30-60-30-60  IBHP: 161# FBHP: 144#  IFP: 80-102 FFP: 87-99  Very, very weak blow.  Rec. 150' mud.</p>																							
USE ADDITIONAL SHEETS, IF NECESSARY, TO COMPLETE WELL RECORD.																							
Date Received	 Signature																						
	Geologist																						
	Title																						
	July 21, 1976																						
	Date																						