

KANSAS


Barber County

FORM 51 5M 6-46 PETROL

Section 31 Township 31 Range 11W

Well No. 1 Regneir (*Regnier*)

Company Olson Drlg. & Globe

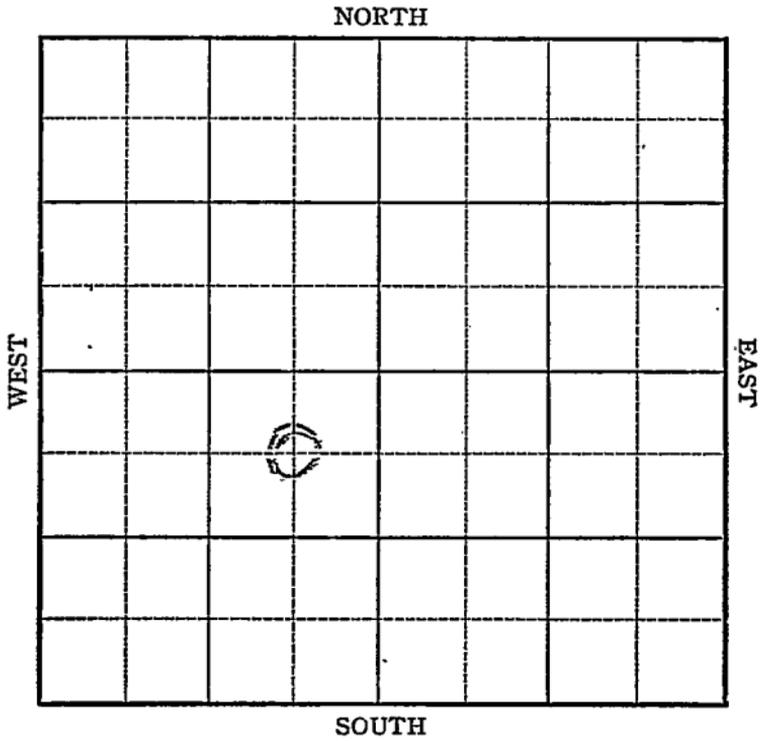

Sec. 31 Twp. 31 R. 11W

Well No. #1 Regneir Farm

Olson Drlg. & Globe Company

Medicine Lodge


660 Ft. from N. Line

_____ Ft. from S. Line

660 Ft. from E. Line

_____ Ft. from W. Line

C NE SW

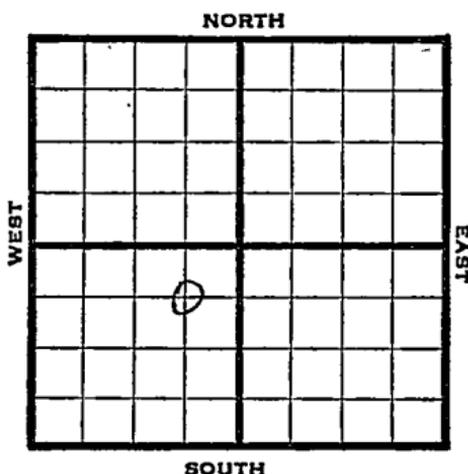

1946 Elev. 1502' REPORT

8/7 Location
 8/13 Surface hole
 8/20 8" @ 159
 sd 3315'
 TD 3335'
 8/27 5" @ 3316 RUST
 9/5 Sand 3315'
 5" @ 3316'
 TD 3335'
 5,965,000 Gas
 1280# R Pr.

COMPLETED

KANSAS Pool Name Medicine Lodge
 Kansas
 Map No. 67 Sec. 31 Twp. 31 R. 11W

Well No. 1 Regneir

Olson Drlg. & Globe Company

FIRST REPORT

Contractor

C NE SW


SECTION PLAT

660 Ft. from N. Line

_____ Ft. from S. Line

660 Ft. from E. Line

_____ Ft. from W. Line

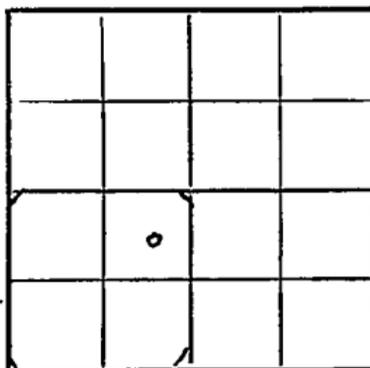

Barber County

Location X

Rig up _____

Drilling and Remarks:

RECORD

Cased _____ in., _____ ft.

Sand _____

Gas _____

Oil _____

Total Depth _____

PRODUCTION

1st 24 hrs. Nat. _____

1st 24 hrs. after shot _____

Gas _____ Cu. Ft.

Dry Hole _____

Abandoned _____

Date

AUG 7 1946 19 _____

S. J. LEWIS Sec

Kansas Pool Name Medicine LodgeMap No. 61 Sec. 31 Twp. 31 R. 11WWell No. 1 RegneirOlson Drlg. & Globe

Company

COMPLETED

Contractor

C NE SW

E1, 1522
SECTION PLAT660 Ft. from N. Line

Ft. from S. Line

660 Ft. from E. Line

Ft. from W. Line

	0		

Barber County

RECORD

Location _____

Cased _____ in, _____ ft.

Rig up _____

Sand _____

Drilling and Remarks:

Gas _____

Oil _____

Total Depth 2985

PRODUCTION

1st 24 hrs. Nat. _____

1st 24 hrs. after shot _____

Gas _____ Cu. Ft.

Dry Hole _____

Abandoned _____

Date

SEP 5 1946S. J. LEWISSec 31

Sand 3315
5" @ 3316
5, 965, 000 Gas

1280 # R/P2

G

Pi