


Section 31 Township 31 Range 11W

Well No. #1 Warren Mortgage

Company Olson & Glove

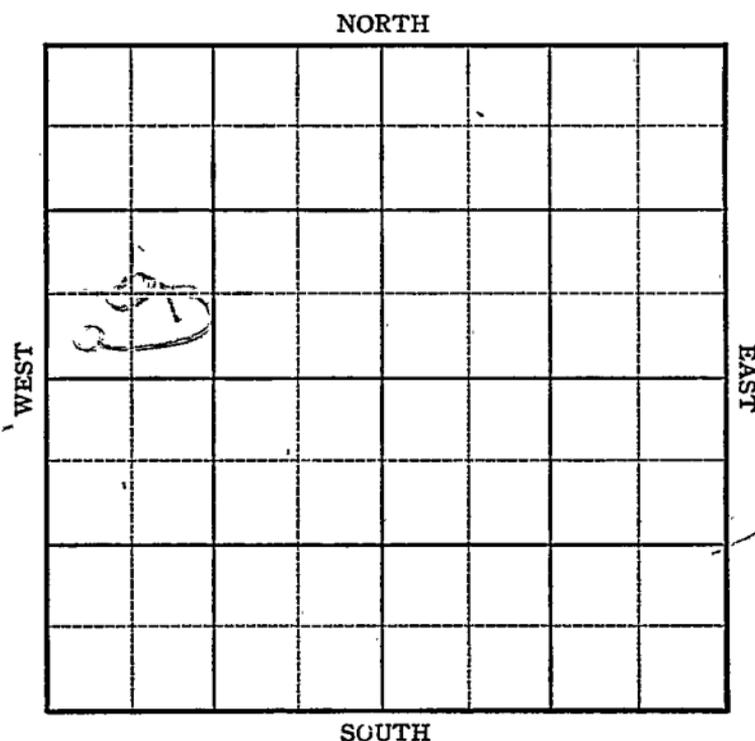





Pool Name Whelan

Map No. 61 Sec. 31 Twp. 31 R. 11W

Well No. 1 Warren Mortgage

Olson & Globe Company

**CORRECTION**

Contractor

C SW NW

**SECTION PLAT**

         Ft. from N. Line

660 Ft. from S. Line

         Ft. from E. Line

660 Ft. from W. Line

o	.		

Barber County

Location                                 

Rig up                                 

Drilling and Remarks:

reported SW NW

**RECORD**

Cased          in.,          ft.

Sand                                 

Gas                                 

Oil                                 

Total Depth                         

**PRODUCTION**

1st 24 hrs. Nat.                         

1st 24 hrs. after shot                         

Gas                                  Cu. Ft.

Dry Hole                                 

Abandoned                                 

Date

APR 11 1945 19        

S. J. LEWIS Scout

Kansas Pool Name WhelanMap No. K 61 Sec. 31 Twp. 31 R. 11WWell No. 1 Warren MortgageOlson & Globe

Company

COMPLETED

Contractor

C SW NW

E 1, 1536  
SECTION PLAT

\_\_\_\_\_ Ft. from N. Line

660 Ft. from S. Line

\_\_\_\_\_ Ft. from E. Line

660 Ft. from W. Line

o			

Barber County

## RECORD

Location \_\_\_\_\_

Cased \_\_\_\_\_ in., \_\_\_\_\_ ft.

Rig up \_\_\_\_\_

Sand \_\_\_\_\_

Drilling and Remarks:

Gas \_\_\_\_\_

Oil \_\_\_\_\_


## PRODUCTION

1st 24 hrs. Nat. \_\_\_\_\_

1st 24 hrs. after shot \_\_\_\_\_

Gas \_\_\_\_\_ Cu. Ft.

Dry Hole \_\_\_\_\_

Abandoned \_\_\_\_\_

Date

MAY 9 1945 19

S. J. LEWIS

Scout