


Section 31 Township 31 Range 11-W

Well No. #2
#1, Warren Mortgage

Company Olson Drilg. etal

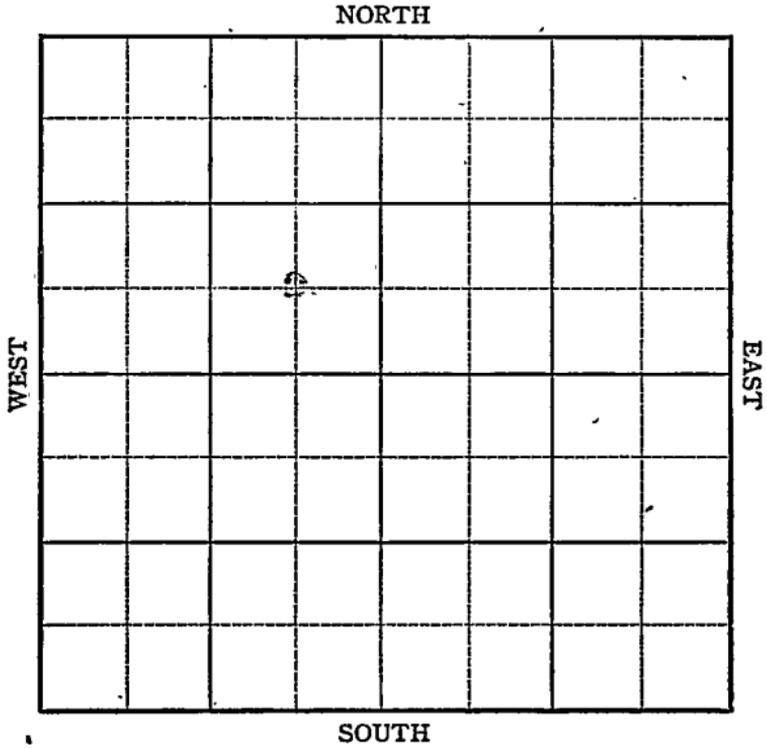

Barber ✓

Sec. 31 Twp. 31 R. 11W

Well No. #2 ~~#1~~ Warren Mortgage Farm

Olson Drlg. etal Company


Medicine Lodge

_____ Ft. from N. Line

660 Ft. from S. Line

660 Ft. from E. Line

_____ Ft. from W. Line

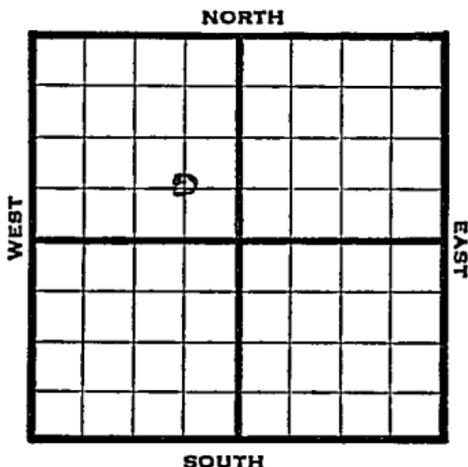

C S ~~E~~ NW

REPORT

1946

Elev. 1509'

- 10/23 RUR
- 10/29 10" @ 169'
Drlg 2060'
- 11/6 3428 SD
- 11/12 Elgin 3304'
Lans 3695'
Drlg 4165'
- 11/20 Miss 4271-97 TD
5" @ 3800, RUST
- 11/27 " "
- 12/4 Miss 4271'
Elgin 3304'
5" @ 3800'
10 M Gas
TD 4297'

COMPLETED

KANSAS Medicine Lodge

Form 26 200 Bks. 10-46 Petrol-

Kansas

Map No. 61 Sec. 31 Twp. 31 R. 11W

Well No. 1 Warren Mortgage

Olson Drlg. etal. Company

FIRST REPORT

Contractor

C SE NW

SECTION PLAT

 Ft. from N. Line

660 Ft. from S. Line

660 Ft. from E. Line

 Ft. from W. Line

	o		

Barber County

Location

Rig up

Drilling and Remarks:

R U R

RECORD

Cased in., ft.

Sand

Gas

Oil

Total Depth

PRODUCTION

1st 24 hrs. Nat.

1st 24 hrs. after shot

Gas Cu. Ft.

Dry Hole

Abandoned

Date

OCT 23 1946 19

S. J. LEWIS Scout

Map No. 61 Sec. 31 Twp. 31 R. 11W

Well No. 2 Warren Mortgage

Olson Drlg. etal. Company

CORRECTION Contractor

C SE NW

SECTION PLAT

	o		

 Ft. from N. Line
660 Ft. from S. Line
660 Ft. from E. Line
 Ft. from W. Line

Barber County

RECORD

Location

Cased in., ft.

Rig up

Sand

Drilling and Remarks:

Gas

Oil

Reported as

Total Depth

#1 Warren Mortgage

PRODUCTION

1st 24 hrs. Nat.

1st 24 hrs. after shot

Gas Cu. Ft.

Dry Hole

Abandoned

Date

NOV 6 1946 19

S. J. LEWIS Scout

*Correct issue
No*

Map No. 1-1 Sec. 31 Twp. 31 R. 11W

Well No. 2 Warren Mortgage

Olson Drlg. etal. Company

COMPLETED

Contractor

E. J. B. 1947

SECTION PLAT

C SE NW

 Ft. from N. Line

660 Ft. from S. Line

660 Ft. from E. Line

 Ft. from W. Line

	6		

Barber County

Location

Rig up

Drilling and Remarks:

*Miss 4271
Elgin 3804
S 1137000*

10M Gas.

RECORD

Cased in., ft.

Sand

Gas

Oil

Total Depth 4297

PRODUCTION

1st 24 hrs. Nat.

1st 24 hrs. after shot

Gas Cu. Ft.

Dry Hole

Abandoned

Date

DEC 4 1946 19

S. J. LEWIS Scout