

KANSAS

Barber


FORM 51 5M 1-42 PETROL

Section 31 Township 31 Range 11-W

Well No. 1 Swartz

Company Great Lake Carbon

NORTH Whelan Pool

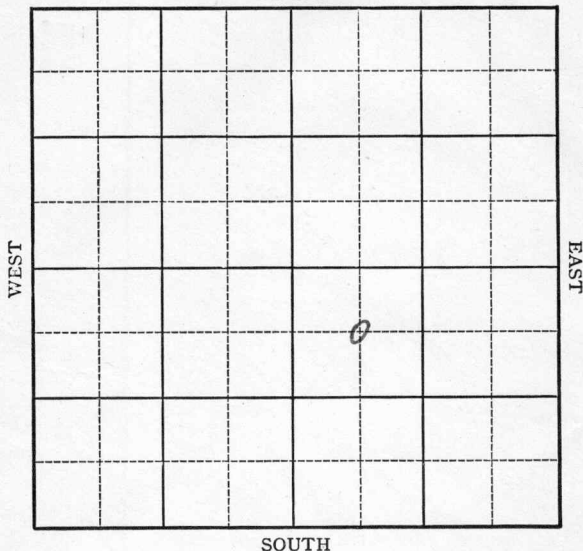

O. W. D. D.

KANSAS

Barber

Sec 31 Twp. 31 R. 11-W

Well No. #1 Swartz Farm

Great Lake Carbon Company

(Whelan)


660 Ft. from N. Line

Ft. from S. Line

Ft. from E. Line

660 Ft. from W. Line

Elev. 1498

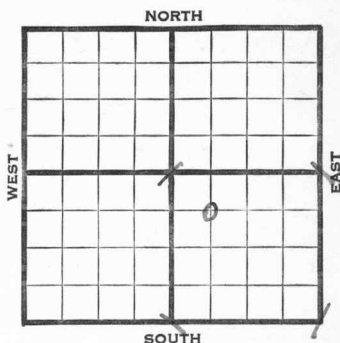

1942	REPORT	O. W. D. D.
2/18	Derrick.	
2/26	8" - 124' Drlg. 2050'	
3/5	Florence 2085' Neva 2330'	
	Drlg. 3300'	
3/12	Topeka 2925' Drlg. 4095'	
3/19	Lans. 3695' Miss. 4271-84' T.D.	
	5" - 4273' RUST.	
3/26	Fsg. tools.	
4/1	Viola 4521'	4521
	T.D. 4619'	1498
	H.F.W.	3023
	ABANDONED	
	OVER	

1942
6/17

O. W. D. D.

Elgin Sand 3312'
5" - 3328'
T.D. 3328'
Drilled to 3323'
36 shots 3313-23'
3,900,000 gas.

FIRST REPORT

and

COMPLETED

Barber

KANSAS

Map No. 61 Sec. 31 Twp. 31 R. 11WWell No. 1 SchwartzFIRST REPORTS Great Lake Carbon Company

COMPLETED

Contractor

C NW SE

SECTION PLAT

		o	

660 Ft. from N. Line

_____ Ft. from S. Line

_____ Ft. from E. Line

660 Ft. from W. Line

O.W.D.D.

RECORD

Location _____

Cased _____ in., _____ ft.

Rig up _____

Sand _____

Drilling and Remarks:

Gas _____

Oil _____

Total Depth 3328Elgin Sand 33125" @ 3328Drilled to 3323364 hots 3313-233,900,000 Gas

PRODUCTION

1st 24 hrs. Nat. _____

1st 24 hrs. after shot _____

Gas _____ Cu. Ft.

Dry Hole _____

Abandoned _____

Date

JUN 17 1942

19


S. J. LEWIS

Scout

Our records show this well as having
been abandoned on April 1, 1942 at total
depth of 4619' with Top Viola 4521'

Please check and advise.

Paul.

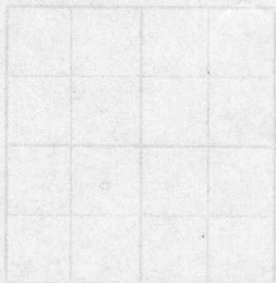

RHD

Misc. Small Maps
Cards
Tracing
France Map
Scarborough Map
Moody Map
Geological Dept.
Moody Plat Book

RHD

Map No. 61 Sec. 31 Twp. 31 R. 11WWell No. 1 Swartz

Great Lake Carbon


Company

FIRST REPORT

Contractor

C NW SE

SECTION PLAT

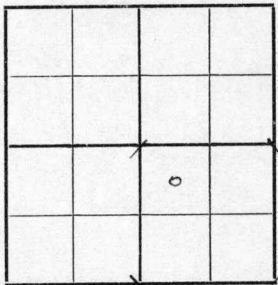660 Ft. from N. Line

_____ Ft. from S. Line

_____ Ft. from E. Line

660 Ft. from W. Line

WHELAN POOL

Location _____

Rig up _____

Drilling and Remarks:

Derrick

RECORD

Cased _____ in., _____ ft.

Sand _____

Gas _____

Oil _____

Total Depth _____

PRODUCTION

1st 24 hrs. Nat. _____

1st 24 hrs. after shot _____

Gas _____ Cu. Ft.

Dry Hole _____

Abandoned _____

Date

FEB 1 8 1942

19

S. J. LEWIS

Scout









Barber

KANSAS

Map No. 61 Sec. 31 Twp. 31 R. 11WWell No. 1 Swartz

Great Lake Carbon Company

~~ABANDONED~~ Contractor

C NW SE


660 Ft. from N. Line

Ft. from S. Line

Ft. from E. Line

660 Ft. from W. Line

SECTION PLAT

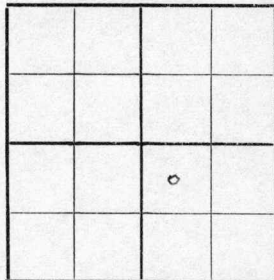

WHELAN POOL

Location _____

Rig up _____

Drilling and Remarks:

*Vista 4521**H.R.W.*

RECORD

Cased _____ in., _____ ft.

Sand _____

Gas _____

Oil _____

Total Depth 4619

PRODUCTION

1st 24 hrs. Nat. _____

1st 24 hrs. after shot _____

Gas _____ Cu. Ft.

Dry Hole _____

Abandoned _____

Date

APR 1 1942 19S. J. LEWIS Scout



































