

KANSAS


FORM 51 5M 6-46 PETROL

Barber county

Section 31 Township 31 Range 11-W

Well No. #1, Swartz

Company Olson Drilling Company

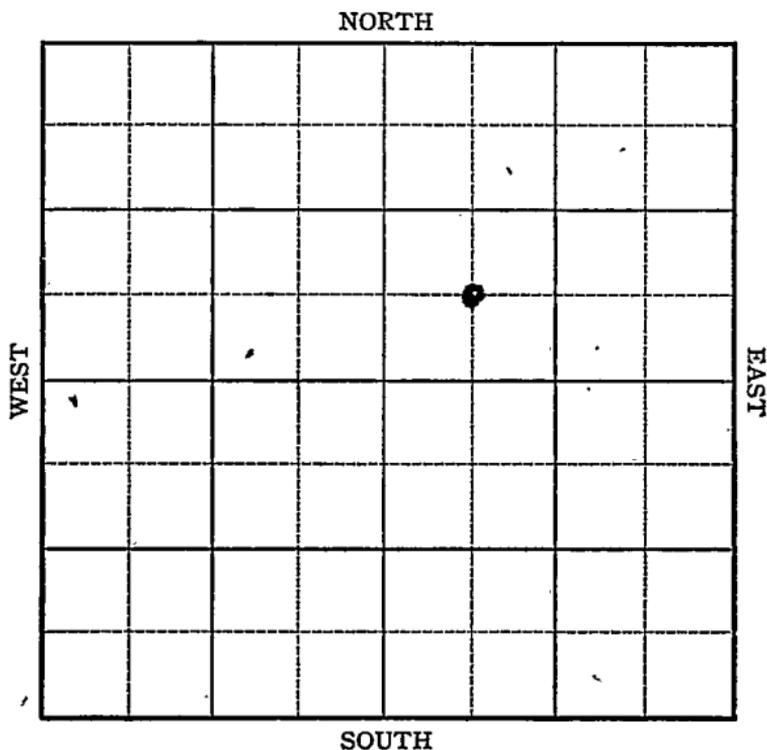

Sec. 31 Twp. 31 R. 11W

Well No. # 1 Swartz Farm

Olson Drlg. Company


Medicine Lodge

 Ft. from N. Line

660 Ft. from S. Line

 Ft. from E. Line

660 Ft. from W. Line

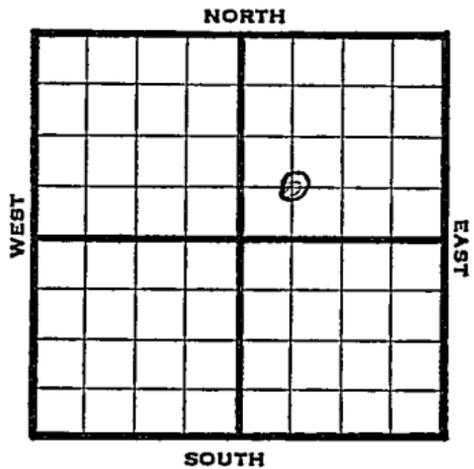

C SW NE

1946 1506 REPORT

8/28	Location
9/5	9" @ 150' Drlg 1850'
9/10	" "
9/18	Elgin sd 3295 Lans 3675 3985 fsg
9/24	" "
10/1	Miss 4262-96 TD 5" @ 4262 RUST
10/8	" "
10/15	TD4295' Est 10 oil PH
10/22	" "
10/29	" "
11/6	" "
11/12	" "
11/20	Miss 4262' 5" @ 4262' TD 4296' Pump 30 oil plus 30% w Pot 37 Grav.

COMPLETED

Kansas Pool Name Medicine Lodge

KANSAS Map No. 61 Sec. 31 Twp. 31 R. 11W

Well No. 1 Swartz

Olson Drlg. Company

FIRST REPORT Contractor

C SW NE


SECTION PLAT

 Ft. from N. Line

660 Ft. from S. Line

 Ft. from E. Line

660 Ft. from W. Line

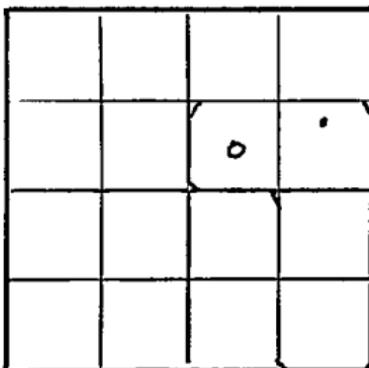

Barber County

Location X

Rig up

Drilling and Remarks:

RECORD

Cased in., ft.

Sand

Gas

Oil

Total Depth

PRODUCTION

1st 24 hrs. Nat.

1st 24 hrs. after shot

Gas Cu. Ft.

Dry Hole

Abandoned

Date:

AUG 28 1946 19

S. J. LEWIS Scout

Map No. 61 Sec. 31 Twp. 31 R. 11W

Well No. 1 Swartz

Olson Drlg. Company

COMPLETED

Contractor

C SW NE

E/1506.
SECTION PLAT

 Ft. from N. Line

660 Ft. from S. Line

 Ft. from E. Line

660 Ft. from W. Line

		o	

Barber County

Location

Rig up

Drilling and Remarks:

Miss 4262
5" C 4262
Pump 3000 + 30%
W Pt

37° SW

RECORD

Cased in., ft.

Sand

Gas

Oil

Total Depth 4296

PRODUCTION

1st 24 hrs. Nat.

1st 24 hrs. after shot

Gas Cu. Ft.

Dry Hole

Abandoned

Date

NOV 20 1946 19

S. J. LEWIS Scout