

KANSAS

Form 51-5M-7-40-Palace

Barber


Section 31 Township 31 Range 11-W

Well No. #1 Schwartz (Swartz)

Company Olson Oil

Whelan pool

NORTH

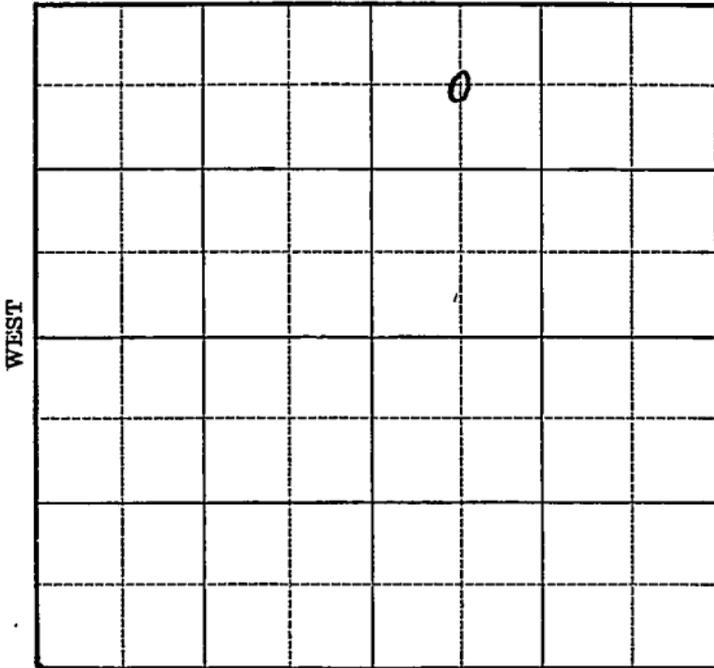

SOUTH

Sec. 3E Twp. 31 R. 11-W

Well No. #1 Schwartz Farm

Olson Oil Company

(Whelan)


660 Ft. from N. Line

_____ Ft. from S. Line

_____ Ft. from E. Line

660 Ft. from W. Line

Elev. 1512

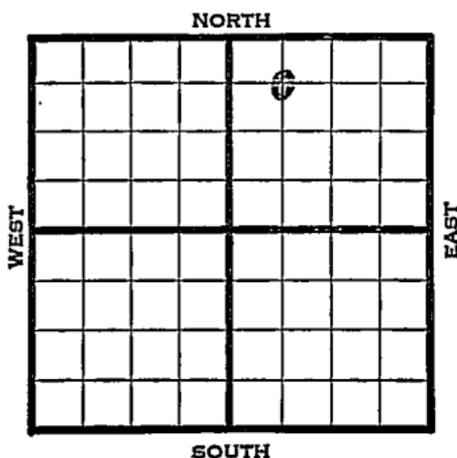

1941

REPORT

5/14 **Cellar.**

5/22 8" - 110' Drlg. 2100'

5/28 K.C. 3690' Drlg. 4006'

6/5 Miss. 4258' 5" - 4262'

T.D. 4294' Flow 28 oil in 5 hours.

6/11 Miss. 4258'

5" - 4262'

T.D. 4294'

Pump & flow 843 bbls., potential

31.6 Gravity

COMPLETED

Map No. 6/ Sec. 31 Twp: 31 R. 11W

Well No. 1 Schwartz

Olson Oil Company

FIRST REPORT Contractor

C NW NE

660 Ft. from N. Line

_____ Ft. from S. Line

_____ Ft. from E. Line

660 Ft. from W. Line

WHELAN POOL

SECTION PLAT

		o	

Location _____

Rig up _____

Drilling and Remarks:

Cellar

RECORD

Cased _____ in., _____ ft.

Sand _____

Gas _____

Oil _____

Total Depth _____

PRODUCTION

1st 24 hrs. Nat. _____

1st 24 hrs. after shot _____

Gas _____ Cu. Ft.

Dry Hole _____

Abandoned _____

Date

MAY 14 1941 19 _____

S. J. LEWIS Scout

Map No. 61 Sec. 31 Twp. 31 R. 11WWell No. 1 SchwartzOlson Oil

Company

COMPLETED

Contractor

SECTION PLAT

C NW NE

660 Ft. from N. Line

_____ Ft. from S. Line

_____ Ft. from E. Line

660 Ft. from W. Line

WHELAN POOL

Location _____

Rig up _____

Drilling and Remarks:

*Shas #258**5" @ 4262**Pump & Flow
#43 P & Y**31 6 32*

RECORD

Cased _____ in., _____ ft.

Sand _____

Gas _____

Oil _____

Total Depth 4294

PRODUCTION

1st 24 hrs. Nat. _____

1st 24 hrs. after shot _____

Gas _____ Cu. Ft.

Dry Hole _____

Abandoned _____

Date

JUN 11 1941 19S. J. LEWIS Scout