
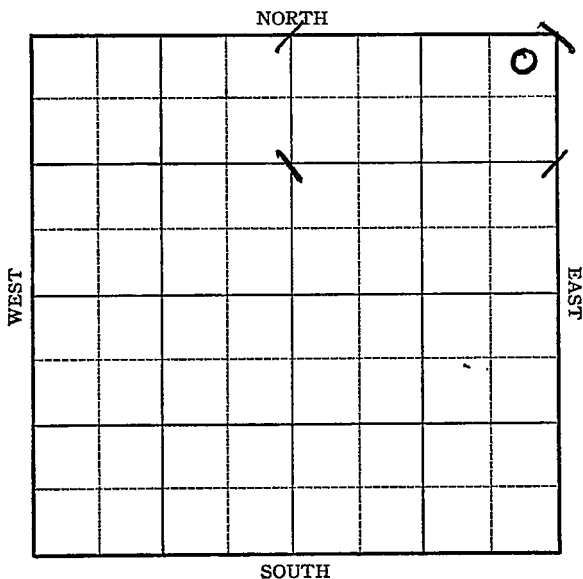


Section 31 Township 31 Range 11-W

Well No. 1 - Swartz

Company Lario Oil

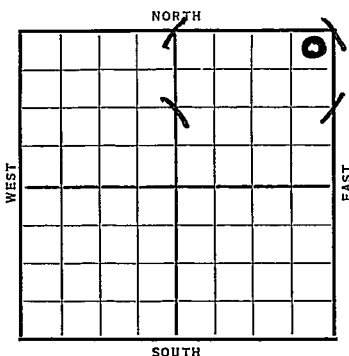

Sec. 31 Twp. 31 R. 11-WWell No. #1 Swartz FarmLario Oil Company330 Ft. from N. Line Ft. from S. Line330 Ft. from E. Line Ft. from W. Line


Date	REPORT
1937	
6/9	Location
6/19	"
6/25	Cellar
7/2	13" @ 105'. WOC.
7/9	Drlg. 2540'.
7/16	Drlg. 3602'.
7/23	Chat 4274'. T.D. 4281'.
	7" @ 4277'. Sm. S.O.
7/30	S.G. 4302'. Oil Pay 4304-08' T.D.
	Flowed by heads 226 bbls. oil 36 hrs
	thru casing.
8/4	7" @ 4277'.
	Chat 4274'.
	T.D. 4308'.
	Pumped & flowed 121 bbls. 4 hrs.
	Pot. 726 bbls.
	COMPLETED

Map No. 61 Sec. 31 Twp. 3 R. 11 WWell No. 1 - SwartzLaris Oil Company

Contractor

FIRST REPORT

SECTION PLAT

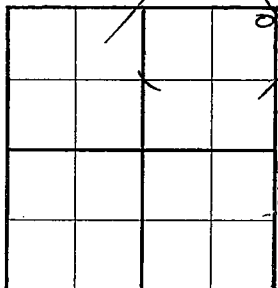330 Ft. from N. Line

_____ Ft. from S. Line

330 Ft. from E. Line

_____ Ft. from W. Line

Location Rig up

Drilling and Remarks:

RECORD

Cased _____ in., _____ ft.

Sand _____

Gas _____

Oil _____

Total Depth _____

PRODUCTION

1st 24 hrs. Nat. _____

1st 24 hrs. after shot _____

Gas _____ Cu. Ft.

Dry Hole _____

Abandoned _____

Date

JUN 9 1937

H. D. Hatfield Scout

Barber **KANSAS**Map No. 61 Sec. 31 Twp. 31 R. 11 WWell No. 1-SwartzLario Company

Contractor

COMPLETED

SECTION PLAT

330 Ft. from N. Line

_____ Ft. from S. Line

330 Ft. from E. Line

_____ Ft. from W. Line

			0

Location _____

Rig up _____

Drilling and Remarks:

Pumped & flowed
121/4 hrs

Pot - 726

RECORD

Cased 7 in., 4277 ft.Sand chat 4274Gas Corrected

Oil _____

Total Depth 4308

PRODUCTION

1st 24 hrs. Nat. _____

1st 24 hrs. after shot _____

Gas _____ Cu. Ft.

Dry Hole _____

Abandoned _____

Date

AUG 4 - 1937

19

H. D. Hatfield Scout