

Seward

KANSAS

SECTION 31 TOWNSHIP 31 RANGE 34W

WELL NO. #1 Stephens

COMPANY Northern Natural

NORTH

			Q				

WEST

EAST

SOUTH

Seward

KANSAS

SEC.	TWP.	R.
31-	31	34W

WELL NO.

#1 Stephens

FARM

COMPANY

Northern Natural

CONTRACTOR

Michaelis

Hugoton

1250

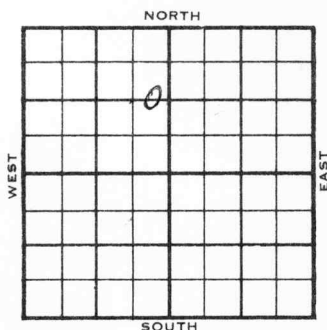
Ft. from N. Line

Ft. from S. Line

100

Ft. from E. Line

Ft. from W. Line

C E $\frac{1}{2}$ E $\frac{1}{2}$ NW

1956

ELEVATION

2955'

REPORT

4-11

Comm. 4-6-56
8" @ 549 w/300

5-29

5 $\frac{1}{2}$ " @ 2761 w/800
 CO 2744, 88/2714-36,
 ga 300 MCF, no ga. , 88/2672-94,
 no ga., 24/2643-49
 Frac 8 x 8, All Zns.
 ga 2.883 MCF, 72-20, 10.237 MCFGPD.
 Herr. 2610'.
 Log tops: Herr. 2610', U. Kri. 2641',
 L. Kri. 2668', Wfd. 2710', U. Ft. Rly.
 2762'.
 TD 2765'

COMPLETED

County Seward Elev. _____
 Sec. 31 Twp. 31 Rgs. 34W
 Company Northern Natural
 Farm Name Stephens No. 1

TOPS	DEPTH	LOG	DATUM
Anh.			
TP.			
H.			
Tr.			
Dg.			
BL.			
L.			
K.C.			
B.K.C.			
Ce.			
C.			
M.			
M.			
K.			
Mz.			
Me.			
V.			
S.			
S.			
A.			
R.			
PE.			
G.			
T.D.			

Loc. in Sec.

C E₁ E₂ NW

1250' NL

100' EL

Geol. _____

Contr. _____

Michaelis

Pool _____

Hugoton

FIRST REPORT

APR 11 1956

Date Comm. 4-6-56

8" @ 549/300

APR 1 5 1956

R.G.

Co.

Use.

No.

Sec.

T.

R.

County

Seward

Elev.

2955

Sec.

31

Twp.

31

Rgs.

3NW

Company

Northern Natural

Farm Name

Stephens

No.

1

TOPS	DEPTH	LOG	DATUM
Anb. <i>Herr</i>	2610	2610	
Tr. <i>U. Kri</i>		2641	
H. <i>L. Kri</i>		2668	
Tr. <i>W.Fd</i>		2710	
Dg. <i>U. F.R. 14</i>		2763	
BL.			
L.			
K.C.			
B.K.C.			
Ce.			
C.			
M.			
M.			
K.			
Mz.			
Ma.			
V.			
S.			
S.			
A.			
R.			
Pe.			
G.			
TD.	2765		

Loc. in Sec.

C E E NW

1250' NL

100' NL

Geol.

Contr.

Michaelis

Pool

Huron

COMPLETE

Date Comm.

4-6-56

MAY 29 1956

8" @ 549/300

APR 18 '56

2640

APR 25 '56

5 1/2 @ 2761/800 MAY 2 '56 CO 2744

~~88/2694-2736~~ MAY 9 '56 88/2714-369a 300 MCF Δ no 9a, 88/2672-94 Δ no 9a 24/2643-49 Δ Frac 8x8 H/I 2ns. 9a 2.8

83 MCF MAY 16 '56 MAY 23 '56 MAY 29 '56 72-20

10, 237 MCF GPD