


Seward

KANSAS

SECTION 31 TOWNSHIP 31S RANGE 33W

WELL NO. #1 Thomas "B"

COMPANY Northern Natural

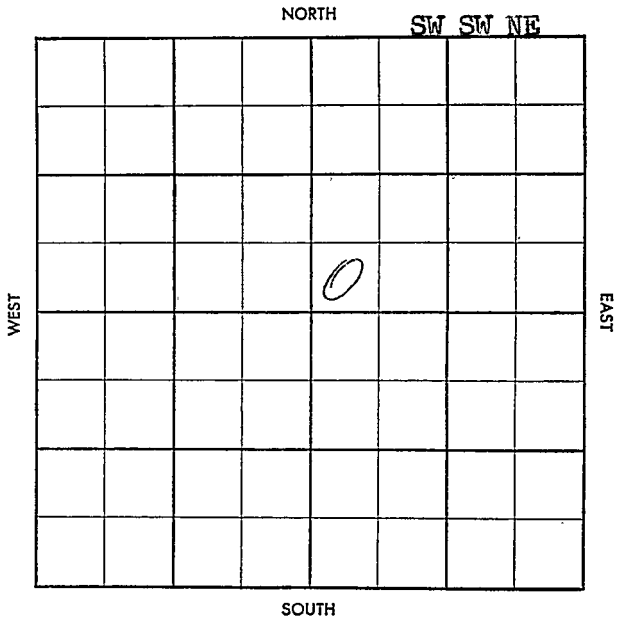

FORM 515 SUNRAY

County Seward

Elev: <sup>Est.</sup> 2773 DF

Sec. 31

Twp. 31

Rgs. 33W

Company Northern Naturat

FarmName Thomas "B"

No. 1

TOPS	DEPTH	LOG	DATUM
Ank.			
Tp. <u>Herr</u>		<u>2454</u>	
H. <u>V. Miller</u>		<u>2509</u>	
Tr. <u>L</u>		<u>2544</u>	
Dg. <u>W in</u>		<u>2538</u>	
Bl. <u>page</u>		<u>2614</u>	
L.			
K.C.			
B.K.C.			
Ce.			
C.			
M.			
M.			
K.			
Mz.			
Mo.			
V.			
S.			
S.			
A.			
R.			
PE.			
G.			
TR	<u>2640</u>		

Loc. in Sec. SW SW NE

Geol.

Contr.

Pool

**FIRST REPORT COMPLETE**

FEB 5 '58

Date Comm.

Location JUL 24 '57 JUL 31 '57 AUG 8 '57 ✓ AUG 14 '57

AUG 21 '57 AUG 28 '57 SEP 4 '57 SEP 11 '57 8-29

95 428/225 WORK

SEP 18 '57 5 2636/600 run log

SEP 25 '57 OCT 2 '57 OCT 9 '57 OCT 16 '57

OCT 23 '57 OCT 30 '57 NOV 6 '57 NOV 13 '57 NOV 20 '57

NOV 27 '57 DEC 4 '57 DEC 11 '57 WOCT DEC 18 '57

DEC 26 '57 JAN 2 '58 JAN 8 '58 JAN 15 '58

JAN 22 '58 JAN 29 '58 CO 258 24/2489

92 16/2515-19 48/2550-62

Co.  
Lse.  
No.  
Sec.  
T.  
R.

5) Frc 34X30 Jan 4. 80.0  
mef 4 1/2 hrs 150 FEB 5 '58  
72-20 12.300 mef  
~~scap~~ SIP 405 #