
Seward KANSAS

SECTION 31 TOWNSHIP 31S RANGE 32W

WELL NO. #1-31 Morgan

COMPANY P.E.P.L.

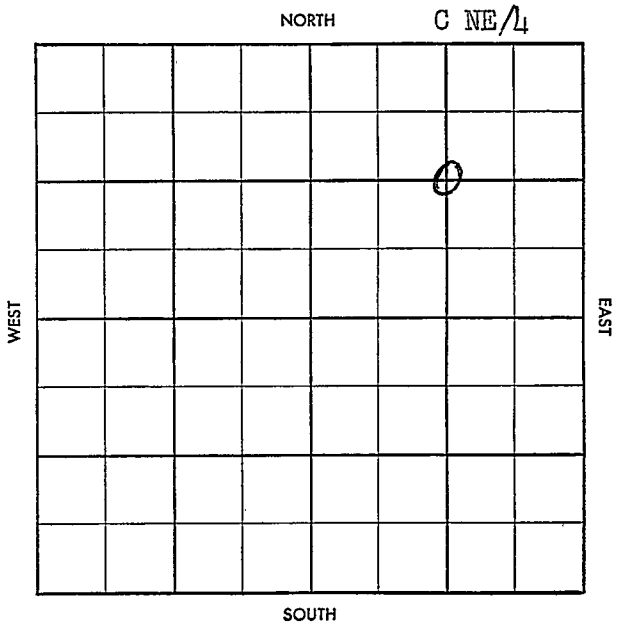

FORM 504-3 SUNRAY

35

S-513-A

CO. Seward ELEV.

SEC. 31 TWP. 31 RGE. 32W FIRST REPORT

COMPANY P.E.P.L. NO. 1-31

DEC 18 57

FARM Morgan

LOC. C NE/4

GEOL.

CONTR. Garvey Tools

POOL Hugoton

SPUD 12/10/57

8" @ 612 w/350, Drlg.

2585.

CO. LSE. NO. SEC. TWP. RGE.

Twp. X Pool X

Co. X Pool X

S-513-A

CO. Seward ELEV 2863DF

SEC. 31 TWP. 31 RGE. 32W

COMPANY P. . F. L. NO. 1-31

MAY 7 '58

COMPLETE

FARM Lorran

LOC. C NE/4

GEOL.

CONTR. [illegible] Tools

POOL [illegible]ctol

SPUD 12/10/57

[illegible] @ 61[illegible]'350, Drl.

2585. [illegible]'57 Kaid

2652 Wim 2742

TD 2760 "

2756/175 CO

2723 24/2700-06

TD 2760

NS 1/2 S of g 64/2686-2700

64/2668-80 48/2644-68 /1

ga 1,500 mcf frac 30x15

ga 4.000 mcf testing

'58 ga 4.000 mcf +125

gwpk wo tst

Lot Top Ho/2591 Hee 2621

Kaid 2645 " " wo tsts

JAN 15 '58 [illegible] FEB 5 '58

FEB 12 '58 FEB 19 '58 FEB [illegible] MAR 5 '58 MAR 12 '58

MAR 19 '58 [illegible] APR 2 '58 APR 9 '58 APR 16 '58

APR 23 '58 [illegible] MAY 7 '58

Stetedel 33 mcf RP 382

BTU 907

CO. LSE. NO. SEC. TWP. RGE.