
DX 78-1

Harper KANSAS

Section 31 Township 31 Range 5W

Well No. 1 Wedman

Company Aurora Gasoline

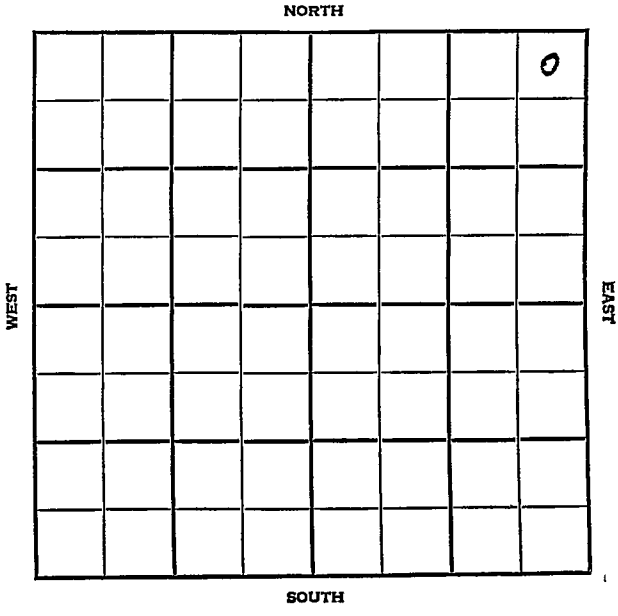

Harper KANSAS

SEC.	TWP.	R.
31	31	5W

WELL NO.

1 Wedman FARM

COMPANY

Aurora Gasoline

CONTRACTOR

Trans-Era


Wildcat

330 Ft. from N. Line

Ft. from S. Line

330 Ft. from E. Line

Ft. from W. Line

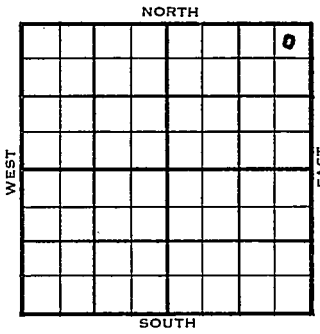

NE NE NE

Skelly Support

1954	ELEVATION 1342'	REPORT

11/10 Location

12/29 Spud 12-3-54 D & A TD 4866
8" @ 165 eeb 3019 Doug. 3107
Stal. 3325 KC 3601 Miss 4230
Kh. 4588 Simp. 4691 Arb. 4837
TD 4866 D & A

ABANDONED

DX-78

FORM 275 FOR SALE BY KANSAS BLUE PRINT CO.

County Harper State Kansas

Sec. 31 (Blk. Twp.) 31 (Sur. Rge.) 5W Map No.

Operator Aurora Gasoline

Well No. 1 Farm Wedman

Elev. 1342 Location NE NE NE



330 Ft. From N Line NE Quarter

330 Ft. From E Line

1st. Report NOV 10 1954

Completion

Remarks Skelly - support
Trans-Era - Contr.

Spudding Date

Drlg. Data Wildcat

Location

FABEN GILSTRAP

FORM 275 FOR SALE BY KANSAS BLUE PRINT CO.


County Harper State Kansas

Sec. 31 (Blk. Twp.) 31 (Sur. Rge.) 5W Map No.

Operator Aurora Gasoline

Well No. 1 Farm Wedman

Elev. 1342 Location NE NE NE

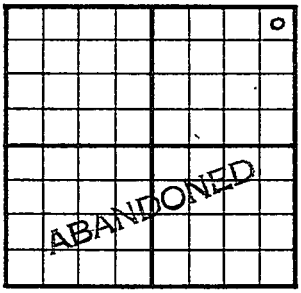

330 Ft. From N Line NE

330 Ft. From E Line Quarter

1st. Report

Completion DEC 29 1954

Remarks Wildcat

Trans-Era - Contr.

Spudding Date 12-3-54

Drlg. Data D & A TD 4866

8" @ 165 Heeb. 3019 Doug. 3107

Stal. 3325 KC 3601 Miss. 4230

Kh. 4588 Simp. 4691 Arb. 4837

TD 4866

D & A

FABEN GILSTRAP