
KANSAS

DX 78-1 HARPER

Section 31 Township 31 Range 8W

Well No. 1 Mary Campbell

Company O. H. Parker

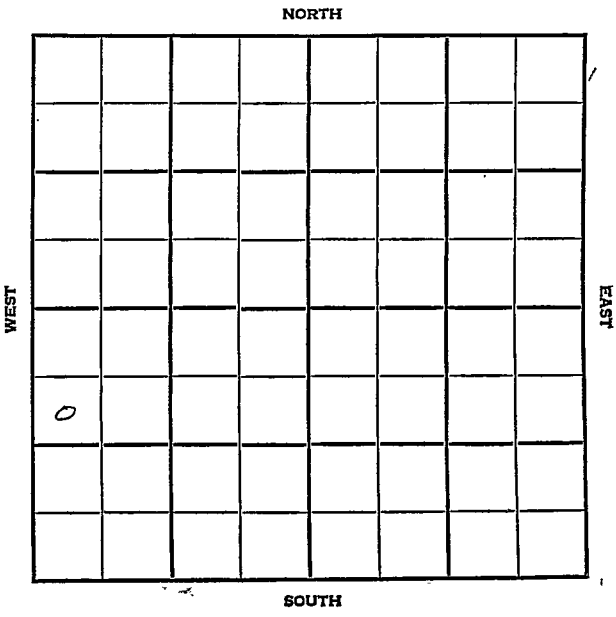

Harper KANSAS

SEC.	TWP.	R.
31	31	8W

WELL NO.

1 Mary Campbell FARM

COMPANY

O. H. Parker

CONTRACTOR


Grabs Pool

990 Ft. from N. Line

_____ Ft. from S. Line

_____ Ft. from E. Line

330 Ft. from W. Line

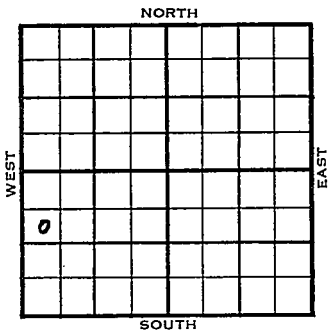

SW NW SW

Sinclair FO

	ELEVATION	REPORT
1955	1533	
3/30		Location
6/8		Comm 4-8-55 H 3369, Dg 3499, M 4366, TD 4373 8" @ 251/175 DST 3499-3510, open ½ hr Rec 450' sw 1385/20 DST 4367-73 open 54 min gas to surface in 1½ min. 277 mcfg 7 min. oil to surface in 42 min Rec 558' oil 1630# 5 1/2" @ 4367/100 CO to 4373 S/7 boph 6 hr. Comp 13 boph 50% wtr. **COMPLETED**

DX-78

FORM 275 FOR SALE BY KANSAS BLUE PRINT CO.


County Harper State Kansas

Sec. 31 (Blk. Twp.) 31 (Sur. Rge.) 8W Map No.

Operator O. H. Parker

Well No. 1 Farm Mary Campbell

Elev. Location SW NW SW

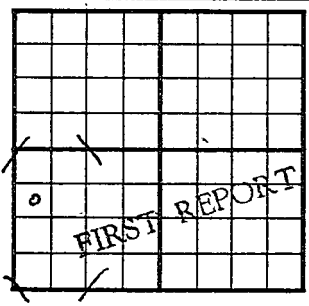

990 Ft. From N Line SW

330 Ft. From W Line Quarter

1st. Report MAR 3 0 1955

Completion

Remarks Sinclair farmout

Spudding Date

Drlg. Data Grabs Pool

Location

FABEN GILSTRAP

FORM 513 REV. SUNRAY

County Harper Elev. 1533

Sec. 31 Twp. 31 Rge. 8W

Company O. H. Parker

Farm Name Mary Campbell No. 1


TOPS	DEPTH	LOG	DATUM
Anh.			
Tp.			
H.	3369		1836
Tr.			
Dg.	3499		1966
Bl.			
L.			
K.C.			
B.K.C.			
Ce.			
C.			
M.	4366		2833
M.			
K.			
Mz.			
Mq.			
V.			
S.			
S.			
A			
R.			
P€.			
G.			
T.D.	4373		

Loc. in Sec. SW NW SW

Geol.

Contr. Prime

Pool Grabs

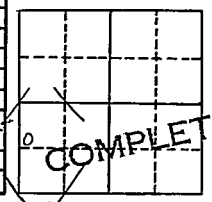

Date Comm. 4-8-55

8" @ 251/175 DST 3499-3510 open ½ hr.

Rec. 450' sw 1385/20" DST 4367-73

open 54 min. gas to surface in 1½ min.

277 mcfg 7 min. oil to surface in 42 min

Rec. 558' oil ~~1630#~~ 5½" @ 4367/100

CO to 4373 S/ 7 boph 6 hr.

Comp. 13 bopd 50% wtr.

Co. Lse. No. Sec. T. R.