

Harper KANSAS

DX 78-1

Section 31 Township 31 Range 8W

Well No. 1 W. L. Carr

Company Magnolia Pet.

NORTH

0							

WEST

EAST

SOUTH

Harper KANSAS


SEC. 31 TWP. 31 R. 8W

WELL NO. _____
 COMPANY 1 W. L. Carr FARM

CONTRACTOR Magnolia Pet

Prime Drlg.
S. Grabs Pool

990 _____ Ft. from N. Line
 _____ Ft. from S. Line
 _____ Ft. from E. Line
330 _____ Ft. from W. Line

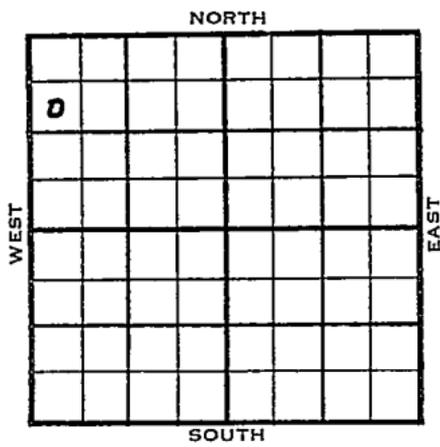

SW NW NW

	ELEVATION	REPORT
<u>1954</u>	<u>1555'</u>	

6/30 Spudding 6-20-54
 9" @ 255
 Drlg. 3400

7/7 Miss 4375
 DST 4374-4406 1 hr. 1620' gassy oil
 235' 0 & GCM 125' wtr 1345# 30"

8/25 Spud 6-20-54 Oil well TD 4460
 9" @ 255 Miss. 4375
 DST 4374-4406 open 1 hr rec 1620'
 gassy oil, 235' 0 & GCM, 125' wtr.
 1345#
 DST 4406-20, open 1 hr, rec 90' 0 &
 GCM, 240' SW 1495# TD 4460'
 5" @ 4459 GO to 4405 60/4383-98
 FU 1600' fluid 6 hr. S/25 BO 3 hr.
 Frac F/151 BO 117 BSW 24 hr.
 P/43 BO 20 BWPD
 Comp. 58 BOPD 38% wtr.

COMPLETED

County **Harper** State **Kansas**

Sec. **31** (Blk. Twp.) **31** (Sur. Rge.) **8W** Map No.

Operator **Magnolia Pet.**

Well No. **1** Farm **W. L. Carr**

Elev. Location **SW NW NW**

0					

990 Ft. From **N** Line **NW**

330 Ft. From **W** Line Quarter

JUN 30 1954

Ist. Report

Completion

Remarks

Prime Drlg. - Contr.

Spudding Date **6-20-54**

Drlg. Data **S. Grabs Pool**

9" @ 255 drlg. 3400

FIRST REPORT

J. G. McGEHEE

