


Barber

Map No. KANSAS Sec. 32 Twp. 31 R. 11^W

Well No. 1 *Helan* Farm
Lario et al Company

1320 Ft. from N. Line
____ Ft. from S. Line
____ Ft. from E. Line
1320 Ft. from W. Line

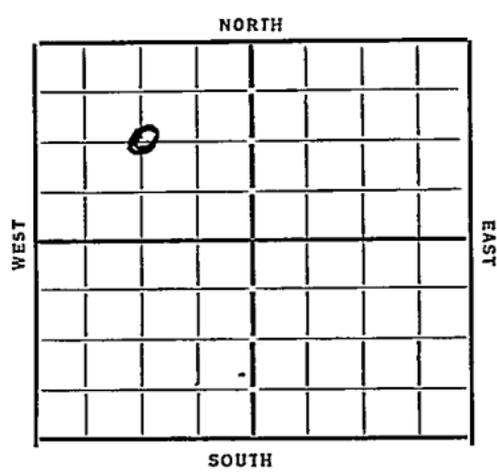

Date	REPORT
1924	
6/13	Moving in
6/21	Ddy.
6/28	5 D 205
7/5	Ddy 2640
7/12	" 3673
7/19	" 4173
7/26	" 4395 Chrt 4350
8/3	Top sand 4355 TD 4428
	8" cemented 4345 Drilled plugs
	hole filled up with 3500 feet
	oil in 2 hrs. & 15 minutes
	Flows every 3 hrs. Makes 10
	minute flows Grav. 28.6 at 74
	Rotary hole (7el)
8/9	8" 4345 TD 4426 Ddy cement
	flow by heads swab 72 oil
	1st hr 41 water next hr.
8/16	Cm back 4395 swab
	225 oil & 400 W 12 hrs,
8/23	— 8/30 — 9/6 —
9/13	Pump 63 oil 180 W 7 hrs.
9/20	— 9/27 — 10/4 — 10/11 —
	— OVER —

10/18 TD 4426 Pump 65 Bbls oil
180 water 7 hrs.

10/25 — 11/1 — 11/8 —

11/14 Chit 4355 TD 4426
PB 4382 75 oil 75 water

COMPLETED

KANSAS

Map No. 61 Sec. 32 Twp. 31 R. 11W

Well No. 1-Whelan

Lasio et al Company

Contractor

FIRST REPORT

SECTION PLAT

1320 Ft. from N. Line

_____ Ft. from S. Line

_____ Ft. from E. Line

1320 Ft. from W. Line

Location _____

Rig up _____

Drilling and Remarks:

Moving in

RECORD

Cased _____ in., _____ ft.

Sand _____

Gas _____

Oil _____

Total Depth _____

PRODUCTION

1st 24 hrs. Nat. _____

1st 24 hrs. after shot _____

Gas _____ Cu. Ft.

Dry Hole _____

Abandoned _____

Date

6-13-37 19

ORVAL MANNSCHRECK

Scout

Map No. 61 Sec. 32 Twp. 31 R. 11W

Well No. 1-Whelan

Laris etal Company

Contractor

SECTION PLAT

	0		

1320 Ft. from N. Line

_____ Ft. from S. Line

_____ Ft. from E. Line

1320 Ft. from W. Line

COMPLETED

Location _____

Rig up _____

Drilling and Remarks:

P.B. 4382.

75 oil
75 water

RECORD

Cased _____ in., _____ ft.

Sand Chat 4355

Gas _____

Oil _____

Total Depth 4426

PRODUCTION

1st 24 hrs. Nat. _____

1st 24 hrs. after shot _____

Gas _____ Cu. Ft.

Dry Hole _____

Abandoned _____

Date

11-14-37 19

ORVAL MANNSCHRECK

Scout

no

will

Returned	<i>CSK</i>
Cards	<i>CSK</i>
Tracing	<i>CSK</i>
France Map	<i>X</i>
Scarborough Map	<i>X</i>
Moody Map	<i>X</i>
Scarborough File	
Moody File	