


Barber

Form 51-5M-5-34-Palace

Map No. **KANSAS** Sec. 32 Twp. 31 R. 11<sup>W</sup>

Well No. 25 W helan Farm \_\_\_\_\_  
Lario Oil Company \_\_\_\_\_

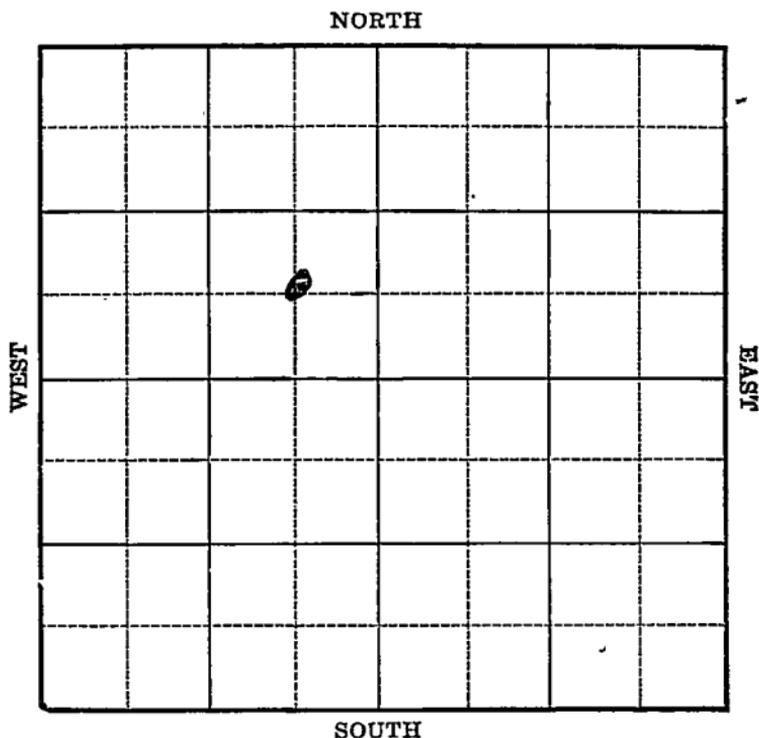

Location \_\_\_\_\_

Drilling Remarks \_\_\_\_\_

\_\_\_\_\_

\_\_\_\_\_

**RECORD**

Cased \_\_\_\_\_ in. \_\_\_\_\_ ft.

Sand \_\_\_\_\_

Gas \_\_\_\_\_

Oil \_\_\_\_\_

Total Depth \_\_\_\_\_

Rig Up \_\_\_\_\_

Drilling Remarks \_\_\_\_\_

\_\_\_\_\_

\_\_\_\_\_

**PRODUCTION**

1st 24 hrs. Nat. \_\_\_\_\_

1st 24 hrs. after shot \_\_\_\_\_

Gas \_\_\_\_\_ cu. ft. \_\_\_\_\_

Dry Hole \_\_\_\_\_


Abandoned \_\_\_\_\_

Barber

Map No. KANSAS Sec. 37 Twp. 31 R. 11W

Well No. 2-Whelan Farm \_\_\_\_\_  
Lario Oil Company \_\_\_\_\_

\_\_\_\_\_ Ft. from N. Line  
660 Ft. from S. Line  
660 Ft. from E. Line  
\_\_\_\_\_ Ft. from W. Line

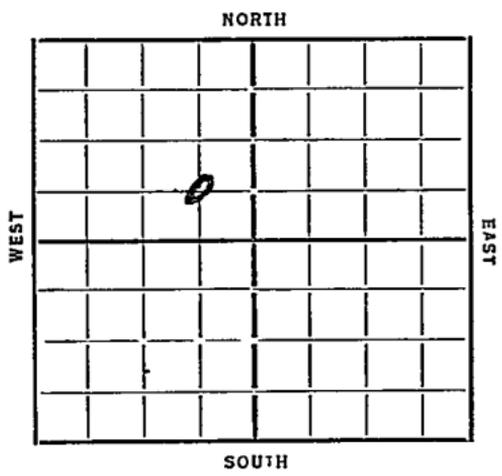

Date	REPORT
7/3/5	
3/2/7	Location
4/4	Bldg
4/11	
4/18	15" 109 WOC
4/26	Bldg 2225
5/2	" 3020
5/9	" 3345
5/16	" 4021
5/23	8" 4324 50 4329
5/29	Building
6/6	Chat 4330 SW 4349
	3000' 4351 Run 6" 4432
6/13	BML 4447 Bldg 4465
6/20	4510 6" parting
6/28	Run 5"
7/3	Bldg 4550
7/11	" 4722 Well 4670-91
7/18	" 4816
8/1	at 4859 3800' Wth
	Set 4939 AD 4975
8/8	PB to Chat
8/15	— (OVER)

8/22 PB 4340  
8/29 — 9/6 —  
9/12 Sil 4939  
T7 4975  
J.F.A.

ABANDONED

Map No. 61 Sec. 32 Twp. 31 R. 11W

Well No. 2-Whelan

Petroleum Company

Contractor

SECTION PLAT

AL 100' 0"

Ft. from N. Line

660 Ft. from S. Line

660 Ft. from E. Line

Ft. from W. Line

	0		

Location

Rig up

Drilling and Remarks:

OV #

RECORD

Cased 2 in. 4939 ft.

Sand oil

Gas

Oil

Total Depth 4975

PRODUCTION

1st 24 hrs. Nat. ....

1st 24 hrs. after shot. ....

Gas ..... Cu. Ft.

Dry Hole. ....

Abandoned. ....

Date

9-12-35 192

ORVAL MANNSCHRECK

Scout



KANSAS

Map No. 61 Sec. 32 Twp. 31 R. 11W

Well No. 2-Whelan

Lario oil Company

Contractor

### FIRST REPORT

### SECTION PLAT

..... Ft. from N. Line

660 Ft. from S. Line

660 Ft. from E. Line

..... Ft. from W. Line


Location  .....

Rig up .....

Drilling and Remarks:

### RECORD

Cased..... in., ..... ft.

Sand .....

Gas .....

Oil .....

Total Depth .....

### PRODUCTION

1st 24 hrs. Nat. ....

1st 24 hrs. after shot .....

Gas..... Cu. Ft.

Dry Hole .....

Abandoned .....

Date

3-27-35 192

ORVAL LIA NSCHRECK

Scout

*Handwritten signature*  
*Handwritten signature*

