

KANSAS


FORM 51 5M 10-41 PETROL

Barber

Section 32 Township 31 Range 11-W

Well No. 1 Whelan

Company Great Lakes Carbon

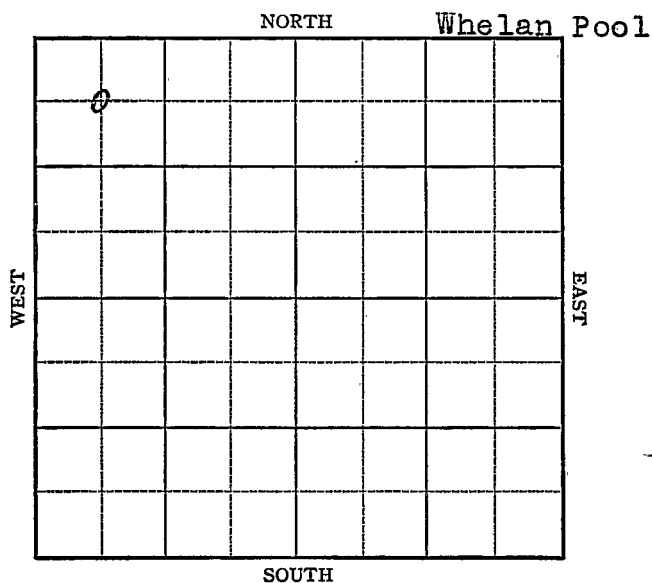

KANSAS

Barber

Sec. 32 Twp. 31 R. 11-W

Well No. #1 Whelan Farm

Great Lakes Carbon Company
(Whelan Pool)


660 Ft. from N. Line

 Ft. from S. Line

 Ft. from E. Line

660 Ft. from W. Line

Elev. 1555

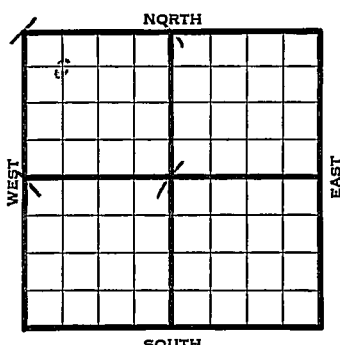

1941	REPORT
12/30	Less Lario Well #1 Well Location
1942	
1/8	"
1/15	"
1/22	"
1/29	8" - 144' Drlg. 1906'
2/5	Drlg. 2934'
2/12	Drlg. 3662'
2/19	Lans. 3755' B.K.C. 4230'
	Miss. 4324' S.S.O. & G. 4324-27'
	5" - 4325' RUST.
2/25	Miss. 4324'
	5" - 4325'
	T.D. 4354'
	2000' water.
	ABANDONED

Map No. 61 Sec. 32 Twp. 31 R. 11WWell No. 1 WhelanGreat Lakes Carbon Company


FIRST REPORT

Contractor

C NW NW

660 Ft. from N. Line Ft. from S. Line Ft. from E. Line660 Ft. from W. Line

SECTION PLAT

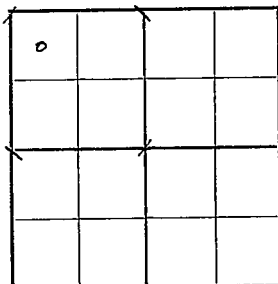

WHELAN P OOL

Location XXRig up

Drilling and Remarks:

Less Lario Well

#1 Well

RECORD

Cased in., ft.Sand Gas Oil Total Depth

PRODUCTION

1st 24 hrs. Nat. 1st 24 hrs. after shot Gas Cu. Ft.Dry Hole Abandoned

Date

DEC 30 1941

19

S. J. LEWIS Scout

Barber

KANSAS

Map No. 61 Sec. 32 Twp. 31 R. 11WWell No. 1 WhelanGreat Lakes Carbon CompanyABANDONED

Contractor

C NW NW

SECTION PLAT

0			

660 Ft. from N. Line Ft. from S. Line Ft. from E. Line660 Ft. from W. Line

WHELAN POOL

Location Rig up

Drilling and Remarks:

Miss 4324
5' @ 4325
2000' Water.

RECORD

Cased in., ft.Sand Gas Oil Total Depth 4,954

PRODUCTION

1st 24 hrs. Nat. 1st 24 hrs. after shot Gas Cu. Ft.Dry Hole Abandoned

Date

FEB 25 1942 19S. I. LEWIS Scout