


Seward KANSAS

DX 78-1

Section 32 Township 31 Range 3/W
Well No. 1 Black "A"
Company Northern Natural

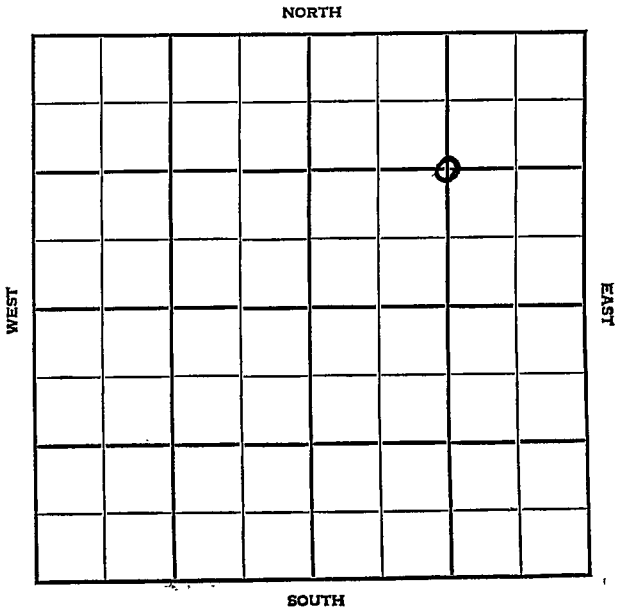

Seward KANSAS

SEC.	TWP.	R.
32	31	34W

WELL NO. 1 Black "A" FARM

COMPANY Northern Natural

CONTRACTOR

1320

Ft. from N. Line


Ft. from S. Line

1320

Ft. from E. Line

Ft. from W. Line

C NE 1/4

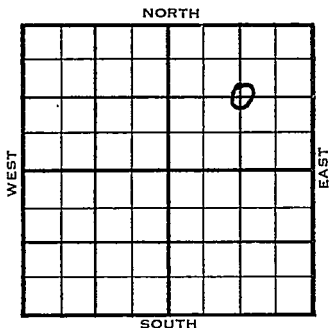

1954

ELEVATION

2896'

REPORT

7/28

10" @ 325
Dr lg. 1457

8/25

Gas well TD 2706 10" @ 325
er. 2575 Hol. 2525 Win. 2680
TD 2766 12000 A 3,825,000 CFG
Schl tops: Kri 2555 Win. 2660
Comp. 13,488,000 CFGPD 392#

COMPLETED

County **Seward** State **Kansas**
 Sec. **32** (Blk.) **31** (Sur.) **34W** Map No.
 Operator **Northern Natural**
 Well No. **1** Farm **Black "A"**
 Elev. Location **C NE/4**

FIRST REPORT

1320 Ft. From **N** Line **NE**
1320 Ft. From **E** Line Quarter

Ist. Report **JUL 28 1954**

Completion


Remarks

Spudding Date

Drlg. Data

10" @ 325 drlg. 1457.

J. G. McGEHEE

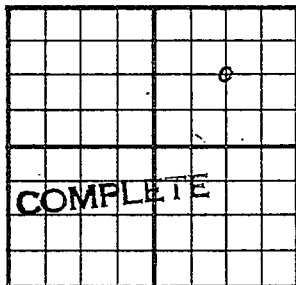County Seward State KansasSec. 32 (Blk. 31 (Sur. 34W Map No. 31 (Rge. 34W)Operator Northern NaturalWell No. 1 Farm Black "A"Elev. 2896 Location C NE/41320Ft. From N Line NE1320Ft. From E Line Quarter1st. Report Completion AUG 25 1954Remarks Spudding Date Drig. Data Gas well TD 270610" @ 325 Her. 2575 Ho1. 2525Win. 2680 TD 2706 12000 A3,825,000 cfg SCHLUMBERGER TOPSKri. 2555 Win. 2660Comp. 13,488,000 cfgpd 392#

FABEN GILSTRAP