

KANSAS

Stevens

Section 32 Township 31 Range 36WWell No. 1 NewbyCompany Texas

Hugoton

NORTH

			0				

WEST

EAST

SOUTH

Stevens

KANSAS

36W

Sec. 32 Twp. 31 R. 36W

Well No. #1 Newby Farm

Texas

Company

Hugoton Pool

Ft. from N. Line


160'

Ft. from S. Line

160'

Ft. from E. Line

Ft. from W. Line

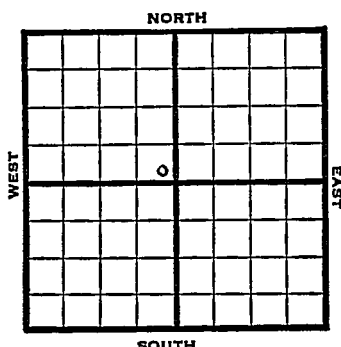

SE NW

1949

Elev 3074'

REPORT

9/7 Location
9/14 10" @ 628'
Drlg 2571'
9/21 TD 2832'
7" @ 2831'
9/28 "
10/5 464 shots 2688-2802
3000 acid
10/12 228 shots 2588-2666-16500 acid
10/19 TD 2832'
7" @ 2831'
Perf
21000 acid
36,436,000 Gas
404# R Pr.
Comp

COMPLETED

Kansas

Hugoton Pool

Map No. _____ Sec. 32 Twp. 31 R. 36W

Well No. 1 Newby

Texas

Company

Contractor

SE NW

FIRST REPORT
SECTION FLAT

Ft. from N. Line


160

Ft. from S. Line

160

Ft. from E. Line

Ft. from W. Line

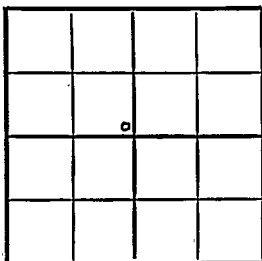

Stevens County

Location X

Rig up

Drilling and Remarks:

RECORD

Cased _____ in., _____ ft.

Sand _____

Gas _____

Oil _____

Total Depth _____

PRODUCTION

1st 24 hrs. Nat. _____

1st 24 hrs. after shot _____

Gas _____ Cu. Ft.

Dry Hole _____

Abandoned _____

Date

SEP 7 1949 19 S. J. LEWIS Scout

Map No. _____ Sec. 32 Twp. 31 R. 36W

Well No. 1 Newby

Texas


Company _____

COMPLETE

Contractor _____

SE NW

E1, 3074
SECTION PLAT

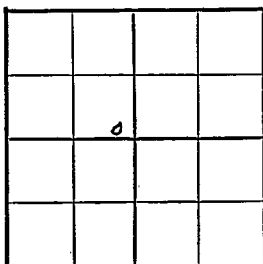

_____ Ft. from N. Line

160

_____ Ft. from S. Line

160

_____ Ft. from E. Line

_____ Ft. from W. Line

Stevens County

RECORD

Location _____

Cased _____ in., _____ ft.

Rig up _____

Sand _____

Drilling and Remarks:

Gas _____

7" C-2831

Oil _____

Total Depth 2832

PRODUCTION

1st 24 hrs. Nat. _____

1st 24 hrs. after shot _____

Gas _____ Cu. Ft.

Dry Hole _____

Abandoned _____

Date

36, 436, 100
404 #R/B
OCT 19 1949 19

S. J. LEWIS Scout