
FORM 51 25M 3-49 PETROL Stevens KANSAS

Section 32 Township 31 Range 35W

Well No. #1 Barnard

Company Northern Natural Gas

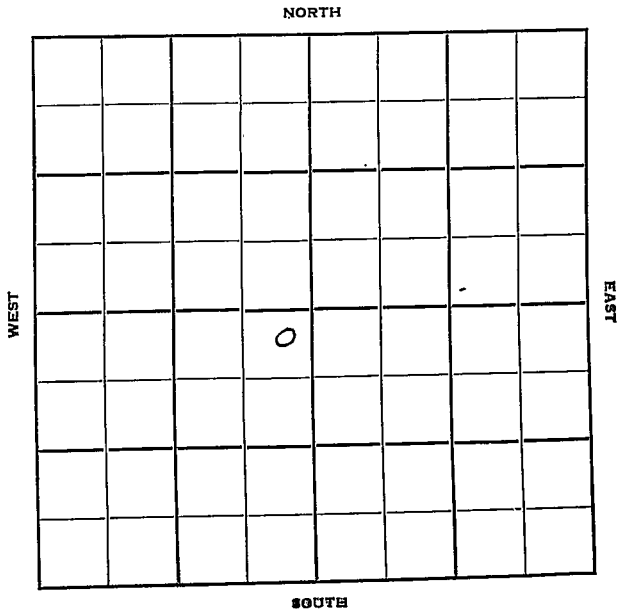

FORM 252-B
10M 9-49 PETROL

Stevens KANSAS

Sec. 32 Twp. 31 R. 35W

Well No. #1 Barnard Farm

Northern Natural Company

Contractor

Hugoton Pool


200' Ft. from N. Line

Ft. from S. Line

200' Ft. from E. Line

Ft. from W. Line

NE SW

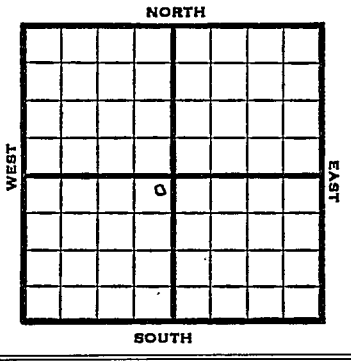

1950	Elev 3023 REPORT
5/3	Spud 4-25-50 10 @ 542' TD 2552' 7" @ 2512' WOC
6/7	TD 2815 10" @ 542 8" @ 2512 23,073,000 cu ft gas per day Hey 2565 Kv 2630-70 Win 2679-2712 Ft R 2740 Completed
	COMPLETED

Form 26 200 Bks. 11-49 Petrol

Kansas

Hugoton Pool

Map No. _____ Sec. 32 Twp. 31 R. 35W

Well No. 1 Barnard

Northern Natural Gas Company

_____ Contractor

NE SW

SECTION PLAT



200 Ft. from N. Line

_____ Ft. from S. Line

200 Ft. from E. Line

_____ Ft. from W. Line

Stevens County

Location _____

Rig up _____

Drilling and Remarks:

Spud 4-25-50

10" @ 542

TD 2552

7" @ 2512

WOC

RECORD

Cased _____ in., _____ ft.

Sand _____

Gas _____

Oil _____

Total Depth _____

PRODUCTION

1st 24 hrs. Nat. _____

1st 24 hrs. after shot _____

Gas _____ Cu. Ft.


Dry Hole _____

Abandoned _____

Date

MAY 3 1950 19

J. E. TYRA Scout

 

MAY 5 1958

Scout Cards .....
Land Small Map .....
Land Wall Map .....
Tracings .....
Fr... .....
Pl... .....
M... .....

Form 26 200 Bks. 11-49 Petrol

Hugoton Pool

Kansas

Map No. _____ Sec. 32 Twp. 31 R. 35w

Well No. 1 Barnard


Northern Natural Company

Contractor

NE SW

El. 3023

SECTION PLAT

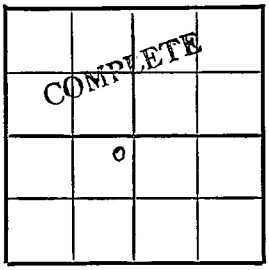

200 Ft. from N. Line

Ft. from S. Line

200 Ft. from E. Line

Ft. from W. Line

Stevens

Location

Rig up

Drilling and Remarks:

10" @ 542

7" @ 2512

23,073,000 cu ft gas per day

RECORD

Cased in., ft.

Sand

Gas

Oil

Total Depth 2815

PRODUCTION

1st 24 hrs. Nat.

1st 24 hrs. after shot

Gas Cu. Ft.

Dry Hole

Abandoned

OVER

Date

JUN 7 1950 19

J. E. TYRA Scout

Hen 2565
Hr 2630-70
Wins 2679-2712
HR 2740

JUN 15 1950

Scout Cards 7W
Land Small Map
Land Wall Map
Tracings
France Map
Pierce Map
Misc.