


Section 32 Township 31 Range 32W

Well No. #1 Simmons "A"

Company Cities Service

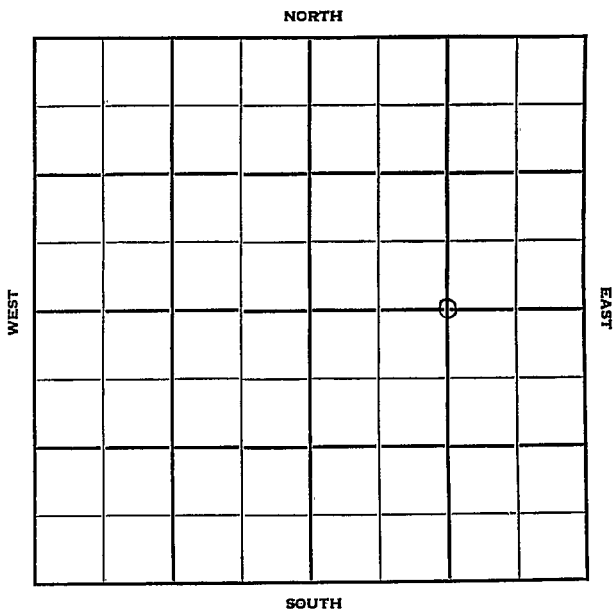

Seward

KANSAS

Sec. 32 Twp. 31 R. 32 W

Well No. # 1 Simmons "A" Farm

Cities Service Company

Contractor

Hugoton Pool


2640 Ft. from N. Line

_____ Ft. from S. Line

1320 Ft. from E. Line

_____ Ft. from W. Line

C E/2 Sec.

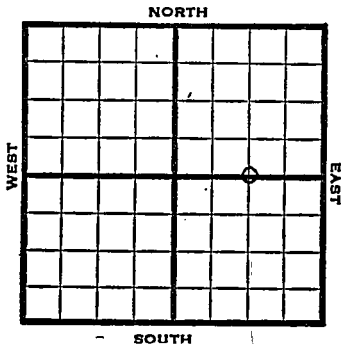

1951

Elev 2853' REPORT

9/12

Spud 9-1-51
8" @ 526' TD 2718' 5" @ 2717'

12/5

Spud 9-1-51
Gas well TD 2718'
8" @ 526' 5" @ 2717' TD 2718'
Her. 2626' Kr. 2656'
120/2684-2708' 70/2658-72
20/2640-44 30/2624-30
12,000 A
Comp. 2,890,000 gas

COMPLETED

County **Seward** State **Kansas**

Sec. **32** (Blk. Twp.) **31** (Sur. Rge.) **32W** Map No.

Operator **Cities Service**

Well No. **1** Farm **Simmons "A"**

Elev. Location **C E/2 Sec.**

2640 Ft. From **N** Line **Sec.**

1320 Ft. From **E** Line **Quarter**

1st. Report **SEP 12 1951**

Completion

Remarks

Spudding Date **9-1-51**

Drilg. Data **Hugoton Pool**

8" @ 526 TD 2718 5" @ 2717

County Seward State Kansas

Sec. 32 (Blk. Twp.) 31 (Sur. Rge.) 32W Map No.

Operator Cities Service

Well No. 1 Farm Simmons "A"

Elev. 2853 Location C E/2 Sec.

2640 Ft. From N Line Sec.

1320 Ft. From E Line Quarter

Ist. Report

Completion DEC 5 1951

Remarks Hugoton Pool

Spudding Date 9-1-51

Drlg. Data Gas well TD 2718

8" @ 526 5" @ 2717 TD 2718

Her. 2626 Kri. 2656 120/ 2684-2708

70/ 2658-72 20/ 2640-44 30/ 2624-30

12000 A Comp. 2,890,000 gas

J. E. TYRA