


Section 32 Township 31 Range 18 W

Well No. # 1 Brinkman

Company Rupp-Ferguson

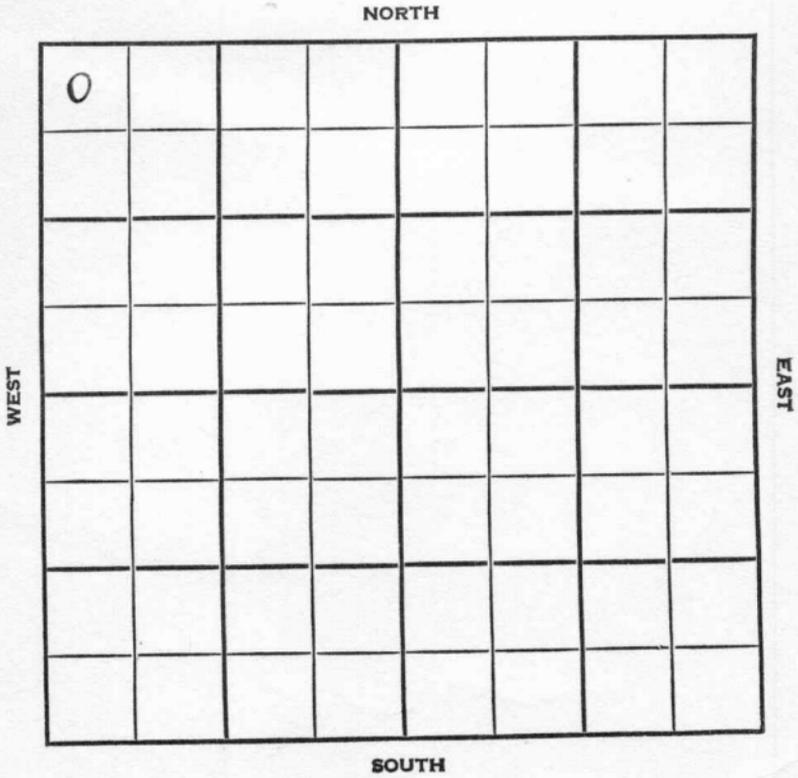

Comanche KANSAS


SEC.	TWP.	R.
32	31	18W

WELL NO. 1 Brinkman FARM

COMPANY Rupp-Ferguson

CONTRACTOR Co. Tools Wildcat

330 Ft. from N. Line
 _____ Ft. from S. Line
 _____ Ft. from E. Line
 330 Ft. from W. Line

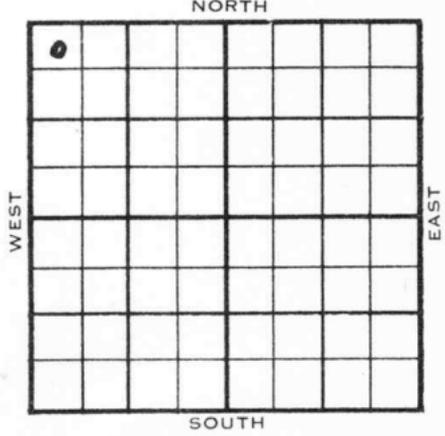

NW NW NW

1954	ELEVATION 2161'	REPORT
------	-----------------	--------

10/13
 11/23

Location
 Spud 10-16-54 - D&A
 TD 5261'
 20" @ 148'
 13" @ 436'
 Elgin 4168', Sd 4186'
 DST 4181-4211', opn 1 hr., rec. 320'
 muddy wtr, 1320#
 Heeb 4298', Marm. 4915', Miss 5161'
 DST 5165-5200', opn 1½ hrs., rec. 02X
 20' mud, Off
 DST 5210-50', opn 1 hr., rec. 30'
 mud, 94' sw, 1360#
 TD 5261'
 D&A

ABANDONED

County **Comanche** State **Kansas**

Sec. **32** (Blk. **31** (Sur. **18W** Map No. (Twp. **31** (Rge. **18W**)

Operator **Rupp-Ferguson**

Well No. **1** Farm **Brinkman**

Elev. Location **NW NW NW**

o									

330 Ft. From **N** Line **NW**

330 Ft. From **W** Line Quarter

1st. Report **OCT 13 1954**

Completion

Remarks

Co. tools

Spudding Date

Drlg. Data **Wildcat**

Location

FABEN GILSTRAP

County **Comanche** State **Kansas**

Sec. **32** (Blk. **31** (Sur. **18W** Map No.

Operator **Rupp-Ferguson**

Well No. **1** Farm **Brinkman**

Elev. **2161** Location **NW NW NW**

0							

330 Ft. From **N** Line **NW**

330 Ft. From **W** Line **Quarter**

1st. Report

Completion **NOV 23 1954**

Remarks **Wildcat**

Co. tools

Spudding Date **10-16-54**

Drlg. Data **D & A TD 5261**

20" @ 148 13" @ 436 Elgin 4168

Sd. 4186 DST 4181-4211 open 1 hr.

Rec. 320' muddy wtr. 1320# Heeb. 4298

Marm. 4915 Miss. 5161 DST 5165-5200

open 1½ hr. Rec. 20' mud 0#

DST 5210-50 open 1 hr. Rec. 30' mud

94' sw 1360# TD 5261

D & A

FAREN OIL STRAD