

KANSAS


FORM 51 5M PETROL

Barber

Section 32 Township 31 Range 14-W

Well No. #1 Mills

Company Dickey Oil

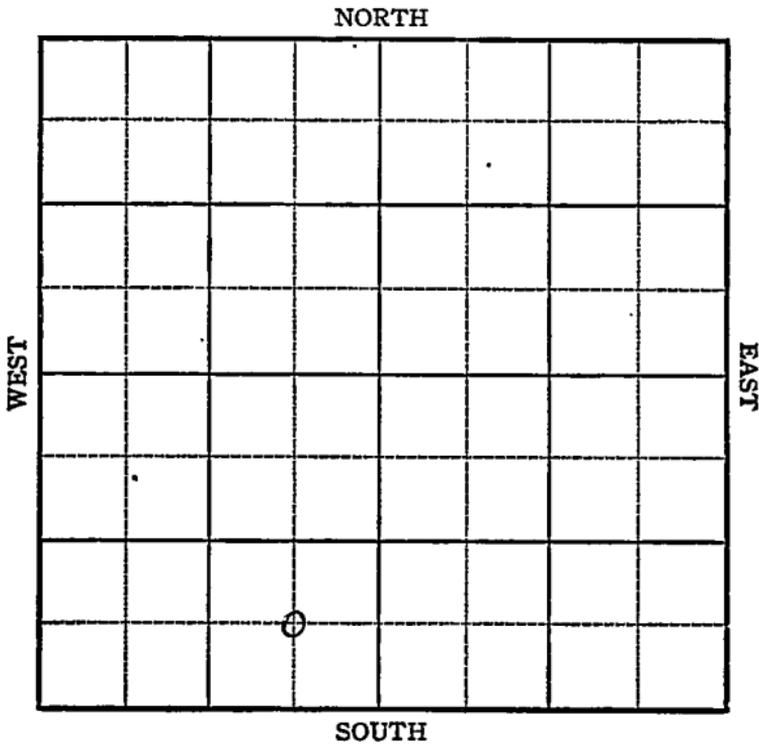

Sec. 32 Twp. 31 R. 14-W

Well No. #1 Mills Farm


Dickey Oil Company

_____ Ft. from N. Line

660 Ft. from S. Line

660 Ft. from E. Line

_____ Ft. from W. Line

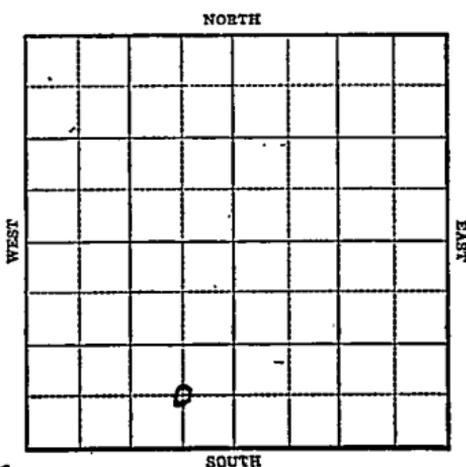

Elev. 1856

1943

R E P O R T

9/8 S.H.
 9/15 12" @ 407'
 Drlg. 945'
 9/22 Drlg. 2828'
 9/29 Drlg. 3669'
 10/6 Topeka 3569.
 Mans 4068
 Drlg. 4380'
 10/13 BKC 4550
 Miss 4602
 Viola 4685
 Drlg. 4707'
 10/20 T.D. 4842
 5" @ 4842
 Rust
 10/27 "
 11/3 "
 11/10 "
 11/17 " "
 11/24 " "
 12/1 SD
 12/8 " "
 12-15 ED 4853'
 500 fluid
 12 hrs. PB

OVER

1943
 12/22 PB 4837
 48 shots 4810-27
 500 acid.
 12/29 Plug 4791 SD
 1944
 1-5 46 shots 4677-4760
 VSSO 17 shots 4610-26 no shows
 57 shots 4470 to 4503-
 760,000 gas
 1-12 10 shots 4119-30, 12 shots
 4130-41 3100' fluid CO
 1/19 Squeeze perforations.
 1/26 " "
 2/2 Perf. 4109-19-500 acid
 1/2 M gas " shows water & oil
 2/8
 2/15 20 shots 4023@25 S gas & oil 5000 acid
 2/23 " " " " " "
 3/1 " " "
 3/8 " " "
 3/15 5" @ 4842
 Topeka 3569
 Lans 4068
 Viola 4685
 Simp. 4838
 TD 4842
 20 shots 4023-25
 500 acid
 3 M. Gas.

COMPLETED

KANSAS

Map No. 93 Sec. 32 Twp. 31 R. 14W

Well No. 1 Mills

Dickey Oil Company

FIRST REPORT Contractor

C SE SW

SECTION PLAT

_____ Ft. from N. Line

660 Ft. from S. Line

660 Ft. from E. Line

_____ Ft. from W. Line'

Wildcat

| | | | |
|--|---|--|--|
| | | | |
| | | | |
| | | | |
| | o | | |

Location _____

Rig up _____

Drilling and Remarks:

S.H.

RECORD

Cased _____ in., _____ ft.

Sand _____

Gas _____

Oil _____

Total Depth _____

PRODUCTION

1st 24 hrs. Nat. _____

1st 24 hrs. after shot _____

Gas _____ Cu. Ft.


Dry Hole _____

Abandoned _____

Date

SEP 8 1943 19

S. J. LEWIS Scout

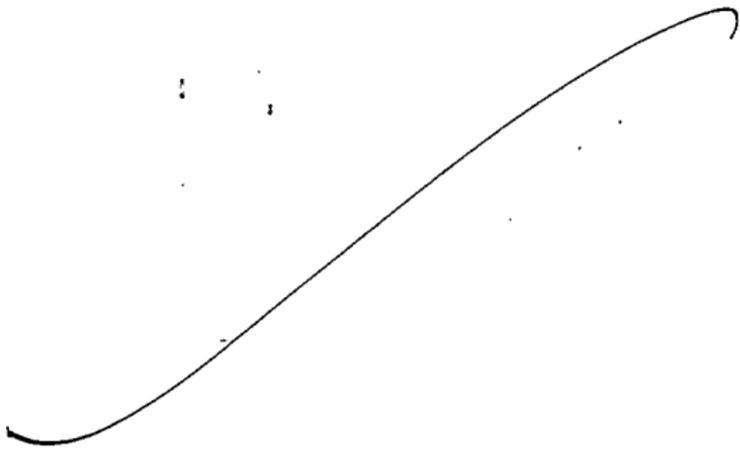

- Misc Small Maps *MB*
- Cards *Beats*
- Tracing *MBL*
- France Map *MB*
- Scarborough Map *MB*
- Moody Map *✓*
- Geological Desk
- Moody Flat Book

KANSAS

Map No. 93 Sec. 32 Twp. 31 R. 14W

Well No. 1 Mills

Dickey Oil Company

COMPLETED Contractor

C SE SW

SECTION PLAT

_____ Ft. from N. Line

660 Ft. from S. Line

660 Ft. from E. Line

_____ Ft. from W. Line

| | | | |
|--|--|--|--|
| | | | |
| | | | |
| | | | |
| | | | |

Wildcat

Location _____

Rig up _____

Drilling and Remarks:

Yopeka 3569
Lone 4068
Vidla 4685
5' @ 4842
5' @ 4888
20' ht to 4029-25
500 acid
3.16 Gas.

RECORD

Cased _____ in., _____ ft.

Sand _____

Gas _____

Oil _____

Total Depth 4842

PRODUCTION

1st 24 hrs. Nat. _____

1st 24 hrs. after shot _____

Gas _____ Cu. Ft.


Dry Hole _____

Abandoned _____

Date

MAR 15 1944 19

S. J. LEWIS Scout

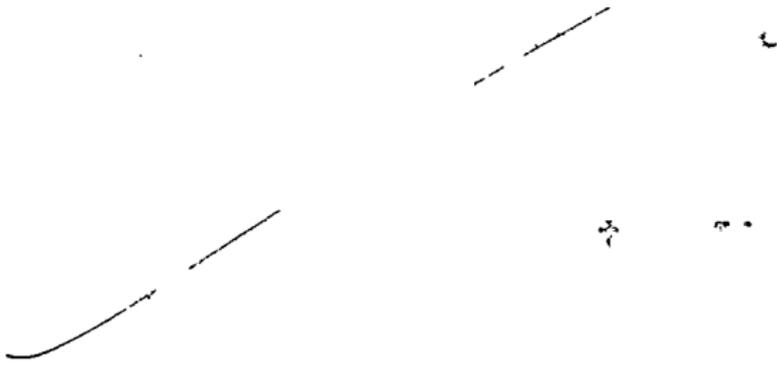

| | |
|------------------|-------------------|
| Misc. Small Maps | <i>Osma</i> |
| Cards | <i>Sweden</i> |
| Tracing | <i>W.E.L.</i> |
| France Map | <i>[initials]</i> |
| Scarborough Map | <i>[initials]</i> |
| Moody Map | <i>[initials]</i> |
| Geological Dept. | |
| Moody Plat Book | |