

KANSAS


Barber

FORM 51 5M BR1X

Section 32 Township 31 Range 14W

Well No. #1, Mills "B"

Company Dickey

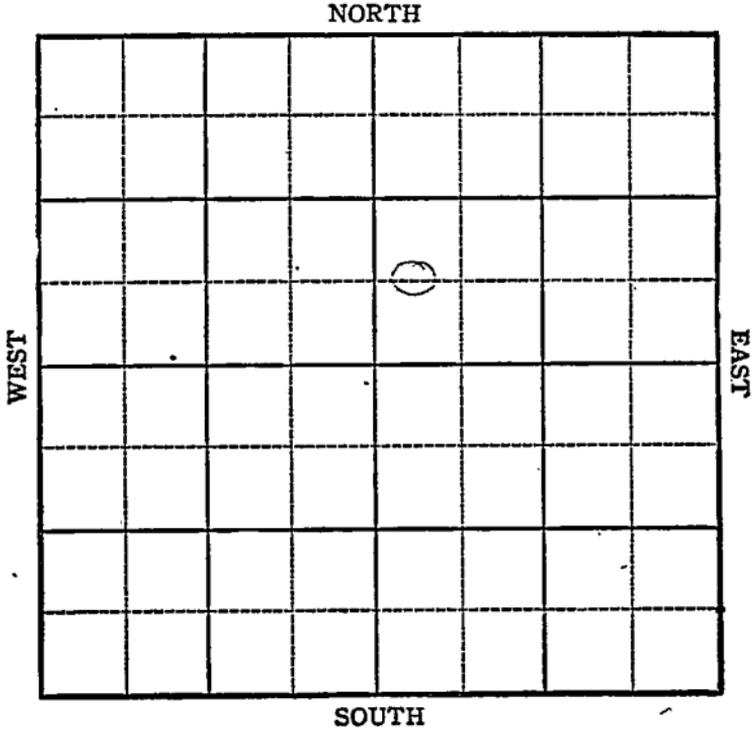

Sec. 32 Twp. 31 R. 14W

Well No. #1 Mills "B" Farm

Dickey Company


Skinner

\_\_\_\_\_ Ft. from N. Line

660 Ft. from S. Line

\_\_\_\_\_ Ft. from E. Line

330 Ft. from W. Line

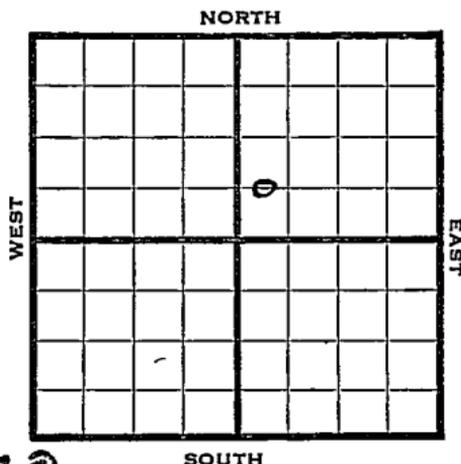

*Elev. 1870*

1944	REPORT
5/24	10" @ 210' Drlg. @ 2685'
5/31	Drlg. 2940
6/7	Drlg. 4389
6/15	Viola 4693-95 TD 7" @ 4693 RUST
6/21	"
6/28	Drlg 4720
7/12	Simp shale 4835 TD 4880
7/19	PB 4745 500 acid SO
7/26	83 shots 4100-11 SSO 500 acid
8/2	34 shots 4112-47 No shows 44 shots 4080 to 4100 No shows SD
8/9	" " " " " " " " " " " "
8/16	" " " " " " " " " " " "
8/23	" " " " " " " " " " " "
8/30	" " " " " " " " " " " "
9/8	" " " " " " " " " " " "
9-13	Simp sd. 4835 7" @ 4693 <del>No shows</del> No shows. TD 4880

**ABANDONED**

**KANSAS**

Pool Name Skinner

Map No. 93 Sec. 32 Twp. 31 R. 14W

Well No. 1 Mills "B"

Dickey Company

FIRST REPORT Contractor

C W L SW NE

**SECTION PLAT**

         Ft. from N. Line

660 Ft. from S. Line

         Ft. from E. Line

330 Ft. from W. Line

		o	

Barber County

Location                                 

Rig up                                 

Drilling and Remarks:  
10" - 210  
2685'

**RECORD**

Cased          in.,          ft.

Sand                                 

Gas                                 

Oil                                 

Total Depth                         

**PRODUCTION**

1st 24 hrs. Nat.                         

1st 24 hrs. after shot                         

Gas                                  Cu. Ft.


Dry Hole                                 

Abandoned                                 

Date

MAY 24 1944 19

S. I. LEWIS Scout

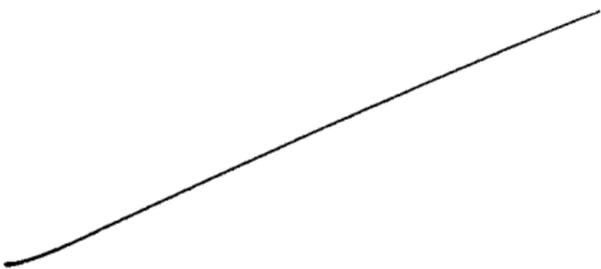

Misc. Small Maps	<i>ma</i>
Cards	<i>cards</i>
Tracing	<i>trac</i>
France Map	<i>fr</i>
Scarborough Map	<i>sc</i>
Pierce Map	<i>pi</i>
Geological Dept.	<i>geo</i>
Pierce Plat Book	<i>pi</i>

Pool Name Skinner PoolMap No. 93 Sec. 32 Twp. 31 R. 14WWell No. 1 Mills "B"Dickey CompanyABANDONED ContractorC W L SW NE

## SECTION PLAT

		0	

Ft. from N. Line

660 Ft. from S. Line

Ft. from E. Line

330 Ft. from W. LineBarber County

Location \_\_\_\_\_

Rig up \_\_\_\_\_

Drilling and Remarks:

Comp. 214735704693No show

## RECORD

Cased \_\_\_\_\_ in., \_\_\_\_\_ ft.

Sand \_\_\_\_\_

Gas \_\_\_\_\_

Oil \_\_\_\_\_

Total Depth 4890

## PRODUCTION

1st 24 hrs. Nat. \_\_\_\_\_

1st 24 hrs. after shot \_\_\_\_\_

Gas \_\_\_\_\_ Cu. Ft.

Dry Hole \_\_\_\_\_

Abandoned \_\_\_\_\_

Date

SEP 13 1944 19\_\_\_\_ S. J. LEWIS Scout

Misc. Small Maps	<i>Reid</i>
Cards	<i>Setty</i>
Tracing	<i>DM</i>
France Map	<input checked="" type="checkbox"/>
Scarborough Map	<i>Reid</i>
Moody Map	<input checked="" type="checkbox"/>
Geological Dept.	
Moody Plat Book	